


# TOWN AND COUNTRY PLANNING (TREES) REGULATIONS 1999

Plan referred to in THE HERTSMERE TREE PRESERVATION ORDER (18 & 20 Watford Road, Radlett, Herts) No 14/2008

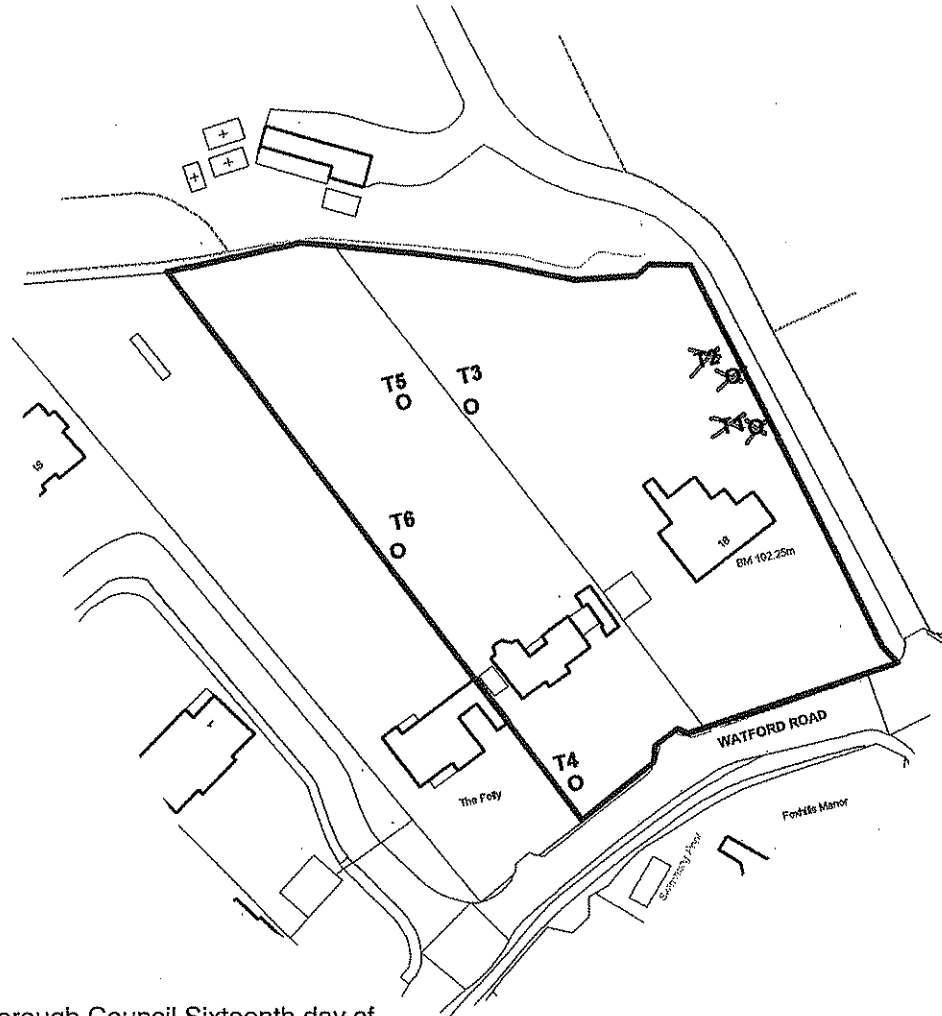

## SCHEDULE OF TREES

| No            | Type                                             |
|---------------|--------------------------------------------------|
| <del>T1</del> | <del>Oak</del> removed 2.4.2009 (sub-comm).      |
| <del>T2</del> | <del>Sycamore</del> removed 2.4.2009 (sub-comm). |
| T3            | Mulberry                                         |
| T4            | Lime                                             |
| T5            | Oak                                              |
| T6            | Cedar                                            |

Signed on behalf of Hertsmere Borough Council Sixteenth day of October 2008

Authorised by the Council to sign in that behalf:

Print name and Position **RICHARD GROVE HEAD OF PLANNING & BUILDING CONTROL**

Reproduced from the Ordnance Survey mapping with the permission of the Controller of Her Majesty's Stationery Office.  
© Crown Copyright reserved. Unauthorised reproduction infringes Crown copyright and may lead to prosecution or civil proceedings.  
Licence Number LA078239 Hertsmere, 2001.

Map Ref: TQ 1577,9986

Hertsmere Borough Council  
Civic Offices  
Borehamwood  
Herts WD6 1WA

SCALE: 1:1250 DATE: 16/10/2008

DRAWN BY: SW CHECKED

DRAWING NUMBER: 14/2008