
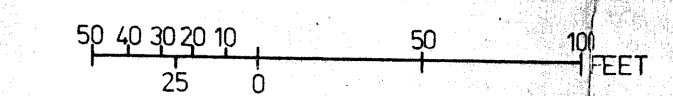


The Common Seal of Hertsmere Borough Council
 was hereunto affixed this 5th day of May
~~1980~~ **1981** in the presence of

[Signature] Mayor of the Borough

[Signature] Borough Secretary

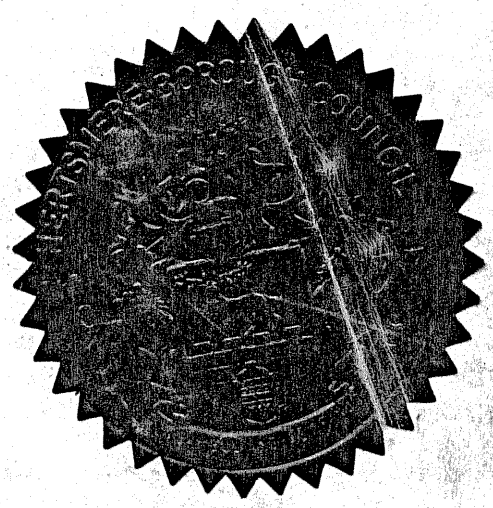


The Hertsmere Borough Council, in exercise of the within written powers conferred upon them in that behalf, hereby confirm the order subject to the amendments shown in red.

In witness whereof the common Seal of the Council was hereunto affixed this twenty-first day of October 1981 in the presence of

[Signature] Mayor

[Signature] Borough Secretary

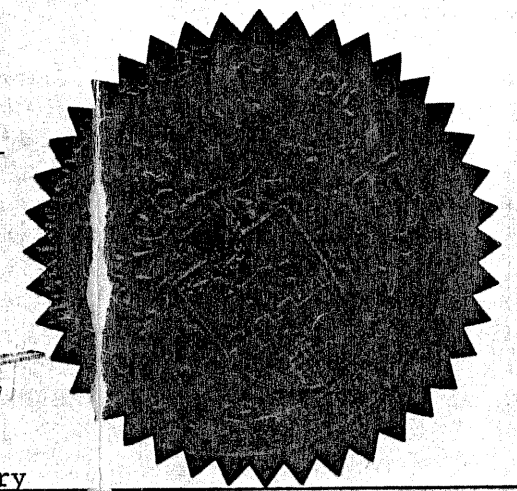

HERTSMERE BOROUGH COUNCIL

M. C. TURNER B.Sc. C.Eng., M.I.Mur.E.
 Chief Technical Officer
 A. J. WHEELER Dip.T.P.
 Principal Development Officer

PLANNING & BUILDING CONTROL

SUBJECT
 Tree Preservation Order
 No. **15/81** (The Grove,
 Radlett.)

SCALE As shown	DATE 17 April 80
DRAWN P.A.C.	CHECKED <i>[Signature]</i>

H.D.C. Ref. No.

H.C.C. Appln. No.

DRAWING No. **TP/243**