


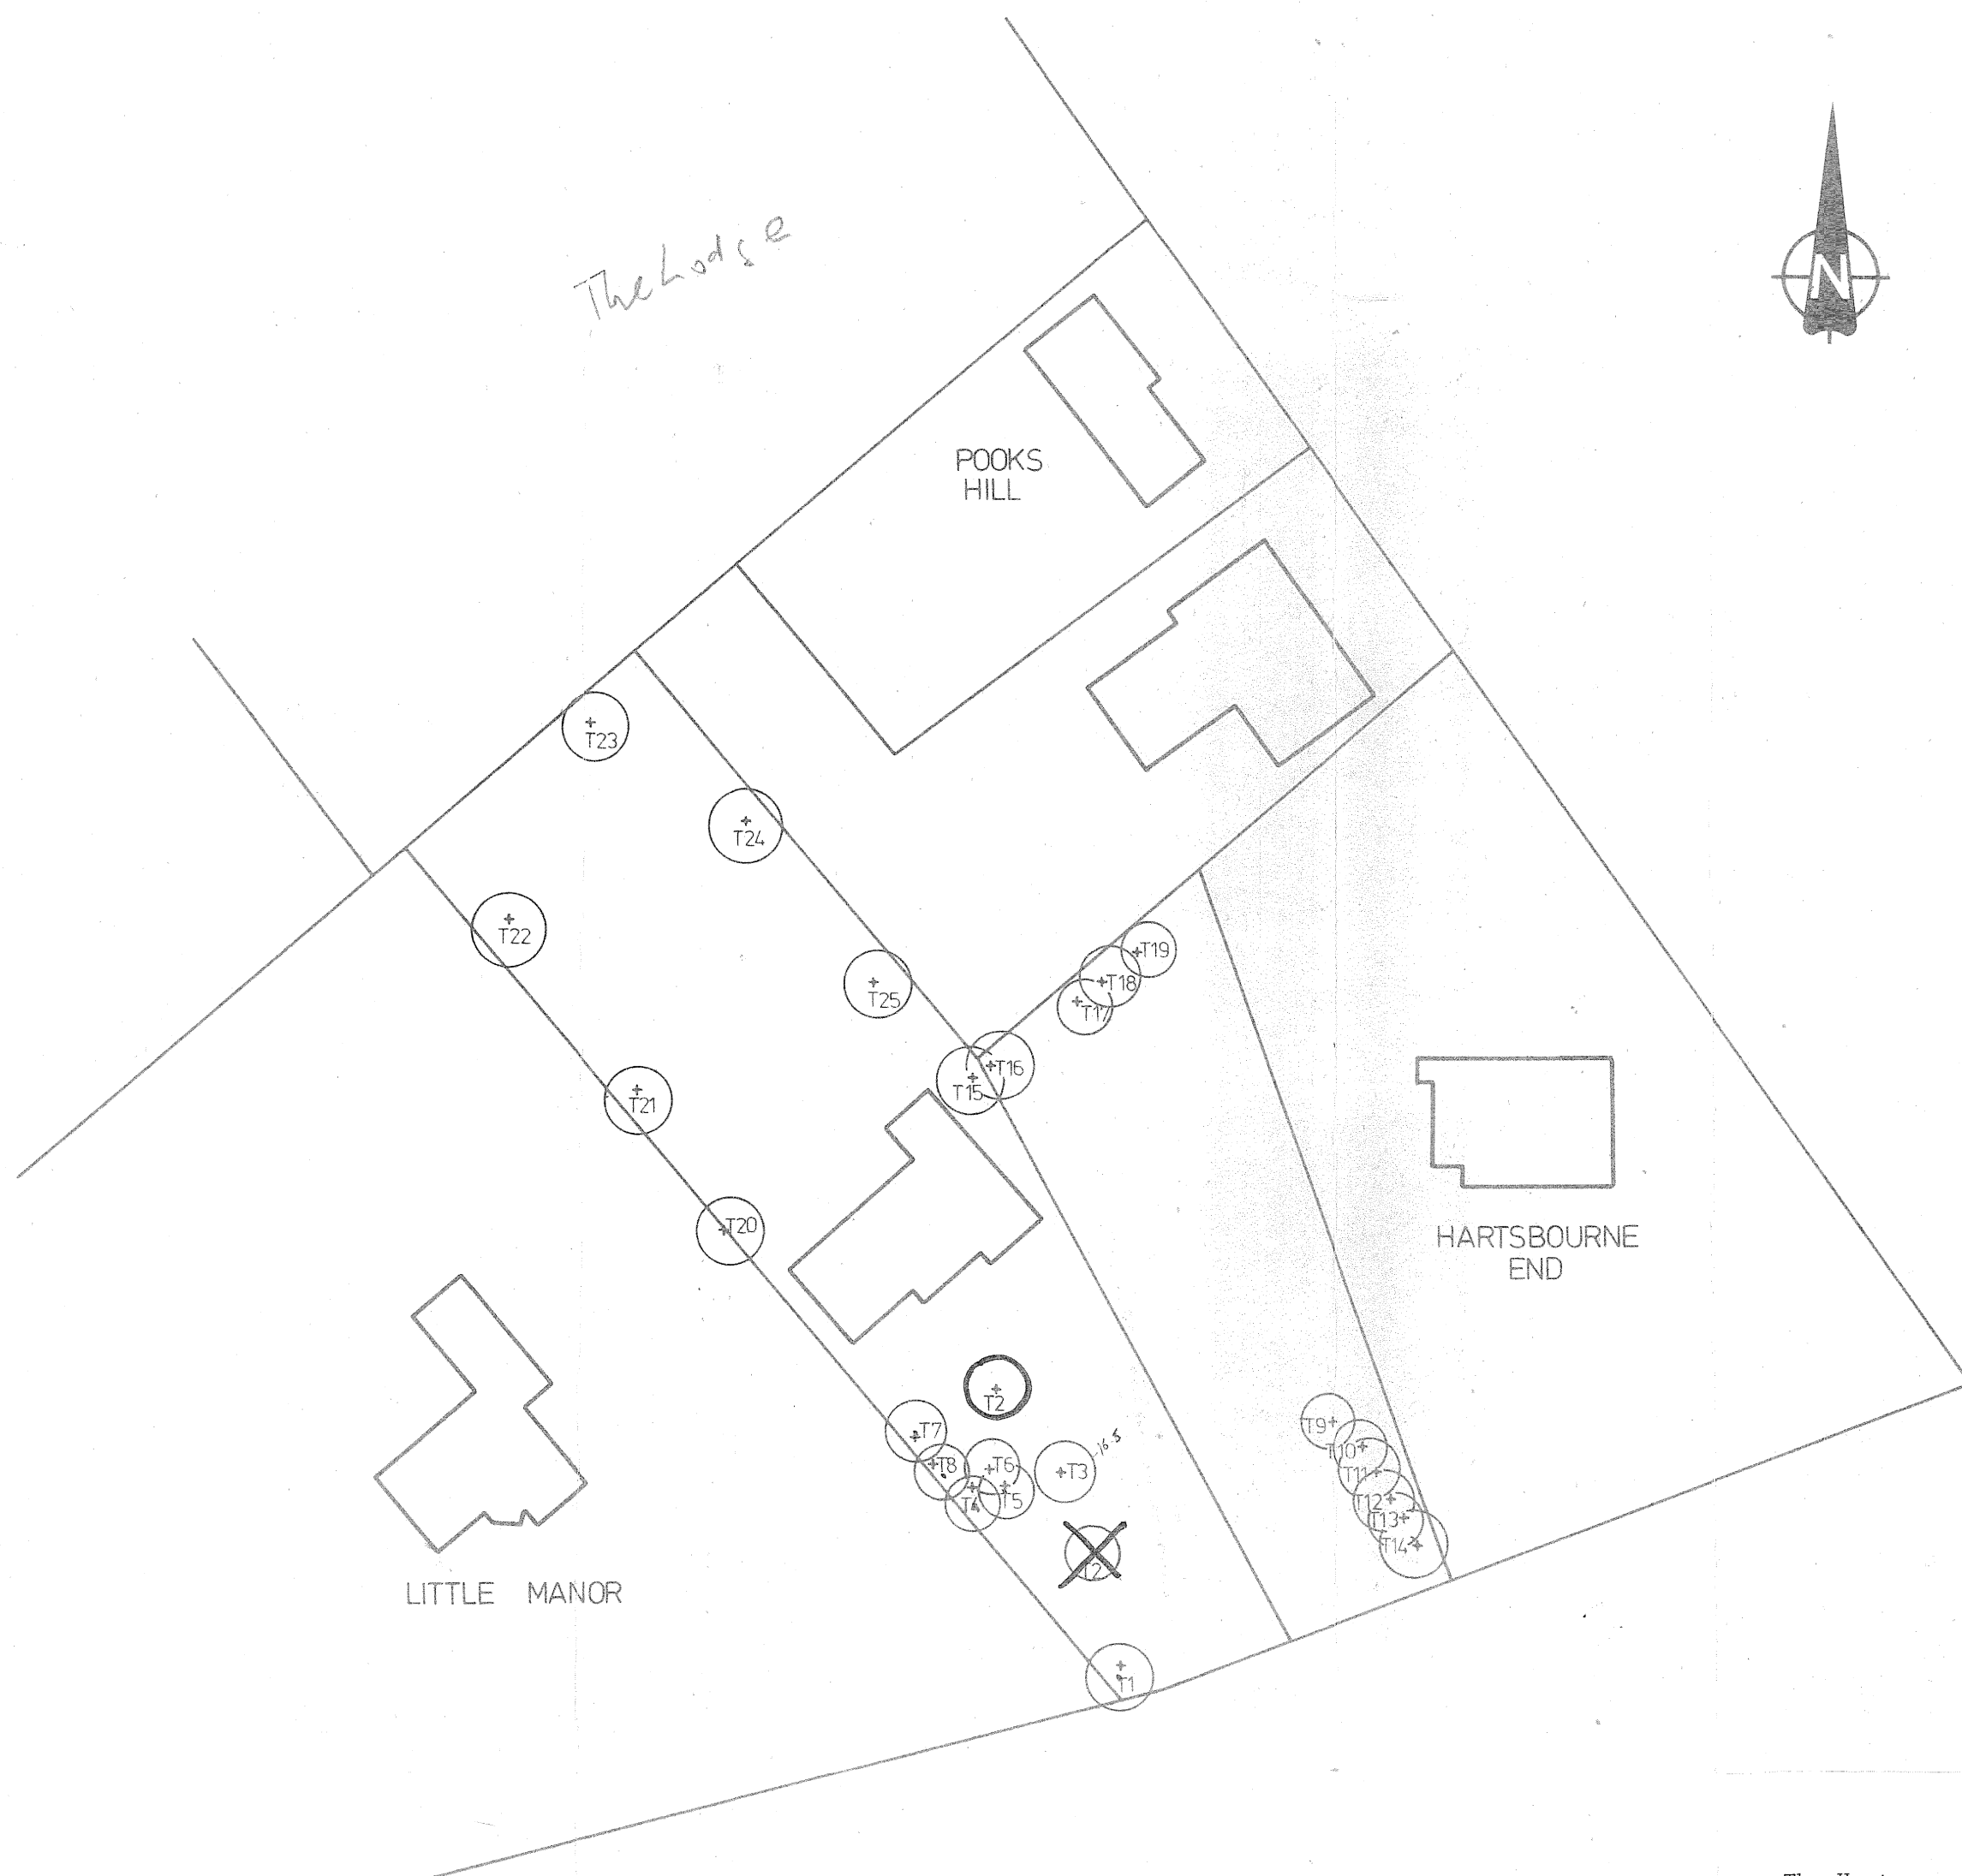

SCHEDULE OF TREES

Nº	TYPE
T1	HOLLY
T2	SILVER BIRCH
T3	SILVER BIRCH
T4	SYCAMORE
T5	OAK
T6	OAK
T7	WILD CRAB
T8	ROWAN
T9	ROWAN
T10	SYCAMORE
T11	SYCAMORE
T12	SYCAMORE
T13	SYCAMORE
T14	OAK
T15	BEECH
T16	BEECH
T17	BEECH
T18	BEECH
T19	BEECH
T20	OAK
T21	OAK
T22	OAK
T23	HORNBEAM
T24	CORSICAN PINE
T25	OAK

HERTSMERE
BOROUGH COUNCIL
M. C. TURNER B.Sc. C.Eng., M.I.Mun.E.
Borough Technical Services Officer
A. J. WHEELER Dip. T.P. (Lond) M.R.T.P.I.
Principal Development Officer

PLANNING & BUILDING CONTROL

SUBJECT
Tree Preservation Order
Nº 21/81 (Land between
Little Manor & Hartsbourne
End, Hartsbourne Road.

SCALE 1:500 DATE 21.8.81

DRAWN P.A.C. CHECKED

H.B.C. Ref. No.

H.C.C. Appln. No.

DRAWING No. **TP/ 284**

The Common Seal of Hertsmere Borough Council
was hereunto affixed this 25th day of AUGUST
1981 in the presence of

(Signed) K.V. BIRCH Mayor of the Borough
(Signed) T.G. LORAIN Administrator
Borough Secretary

The Hertsmere Borough Council, in exercise of the within written powers conferred upon them in that behalf, hereby confirm the order subject to the amendments shown in red.

In witness whereof the common Seal of the Council was hereunto affixed this twenty-ninth day of October 1981 in the presence of L. S.

(Signed) K.V.W. BIRCH Mayor
(Signed) T.G. LORAIN Administrator