


SCHEDULE OF TREES.


No.	TYPE
T1	ALDER
T2	OAK
T3	PINE (ORNAMENTAL)
T4	OAK
T5	YEW
T6	CYPRESS
T7	HAWTHORN
T8	BIRCH
T9	OAK
T10	PLUM (ORNAMENTAL)
T11	YEW
T12	HOLLY
T13	GLADITCHIA
T14	MAPLE SWEDISH WHITEBEAM
T15	APPLE (ORNAMENTAL)
T16	ASH
T17	ASH
T18	SYCAMORE (ORNAMENTAL)
T19	OAK
T20	OAK
T21	OAK
T22	YEW
T23	ASH
T24	MAPLE
T25	PRUNUS (ORNAMENTAL)

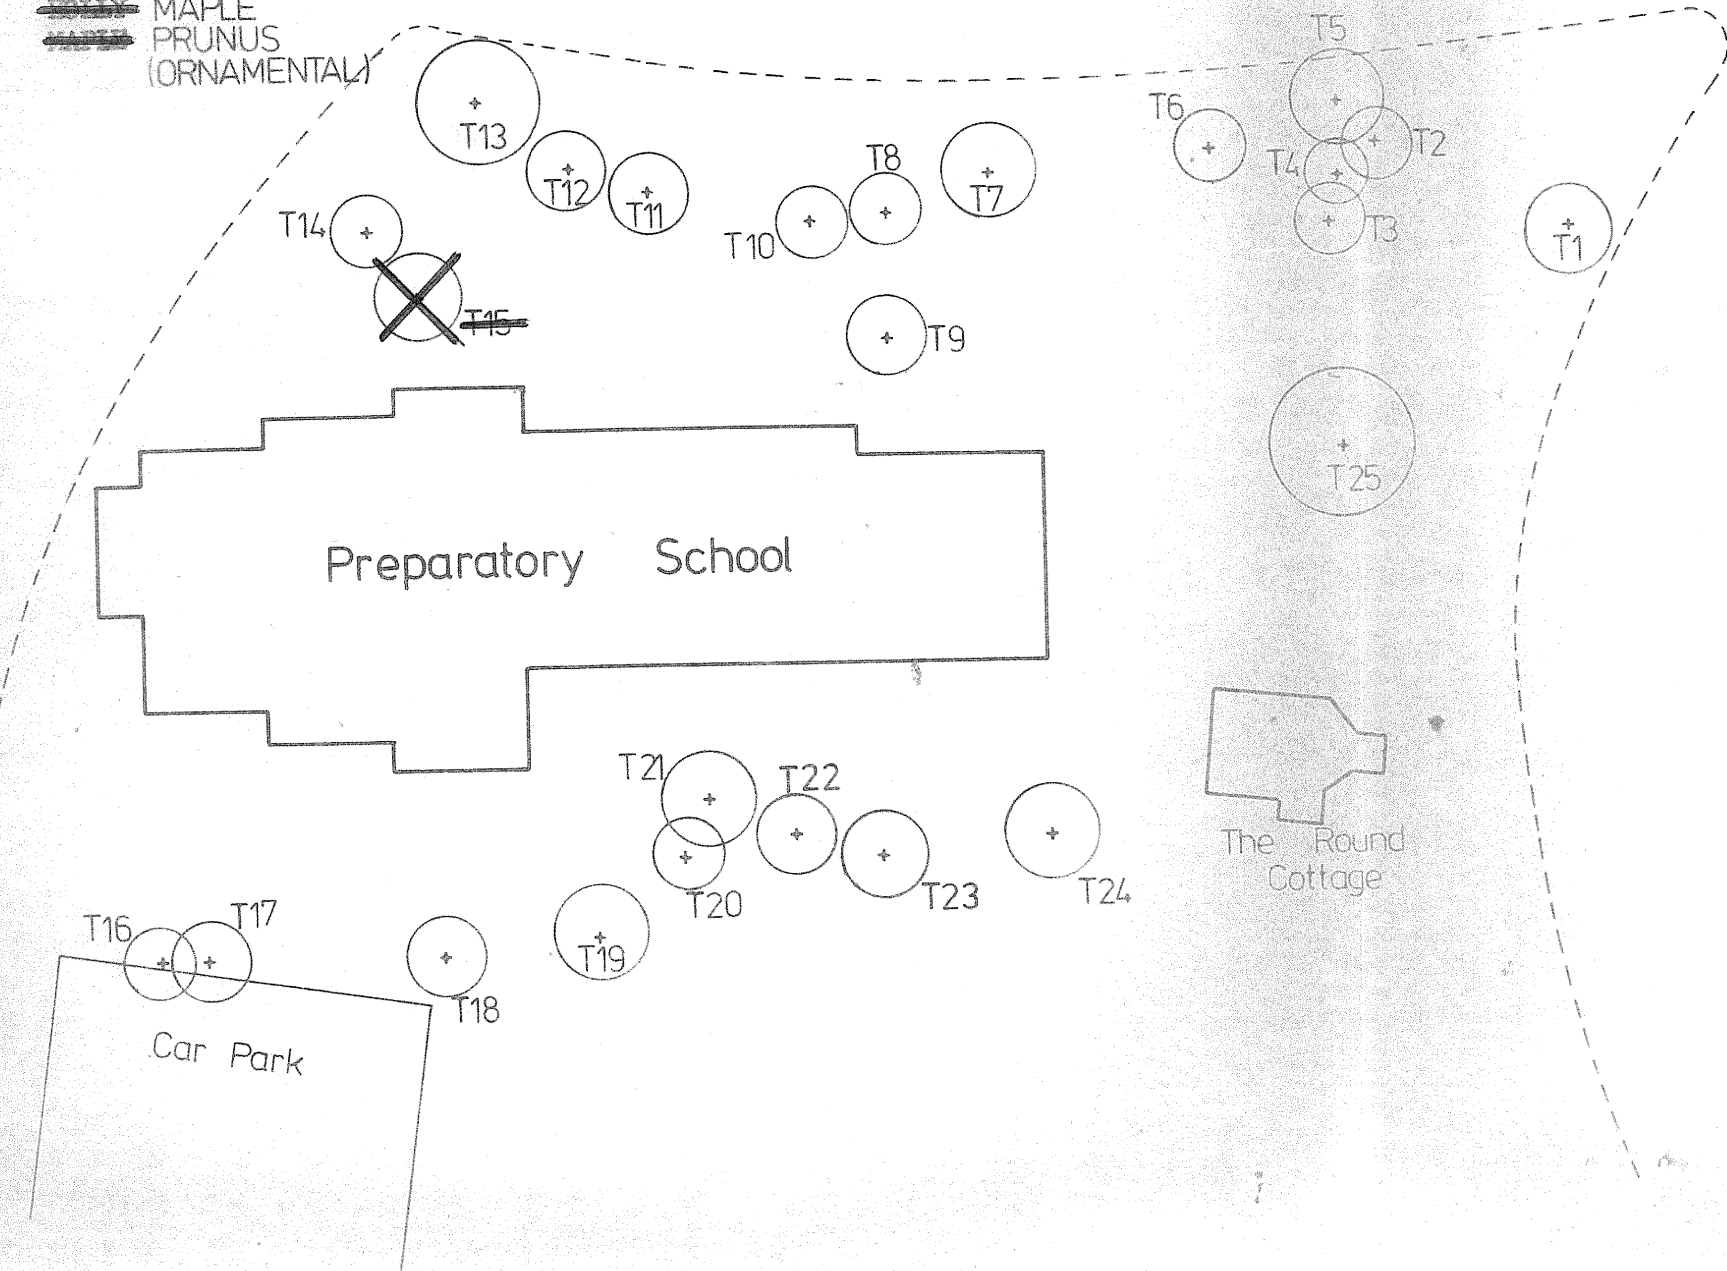

The Common Seal of Hertsmere Borough Council was hereunto affixed this 22nd day of April 1982 in the presence of

(SGD) K.V.W.BIRCH Mayor of the Borough

(SGD) S.J.EVANS Borough Secretary

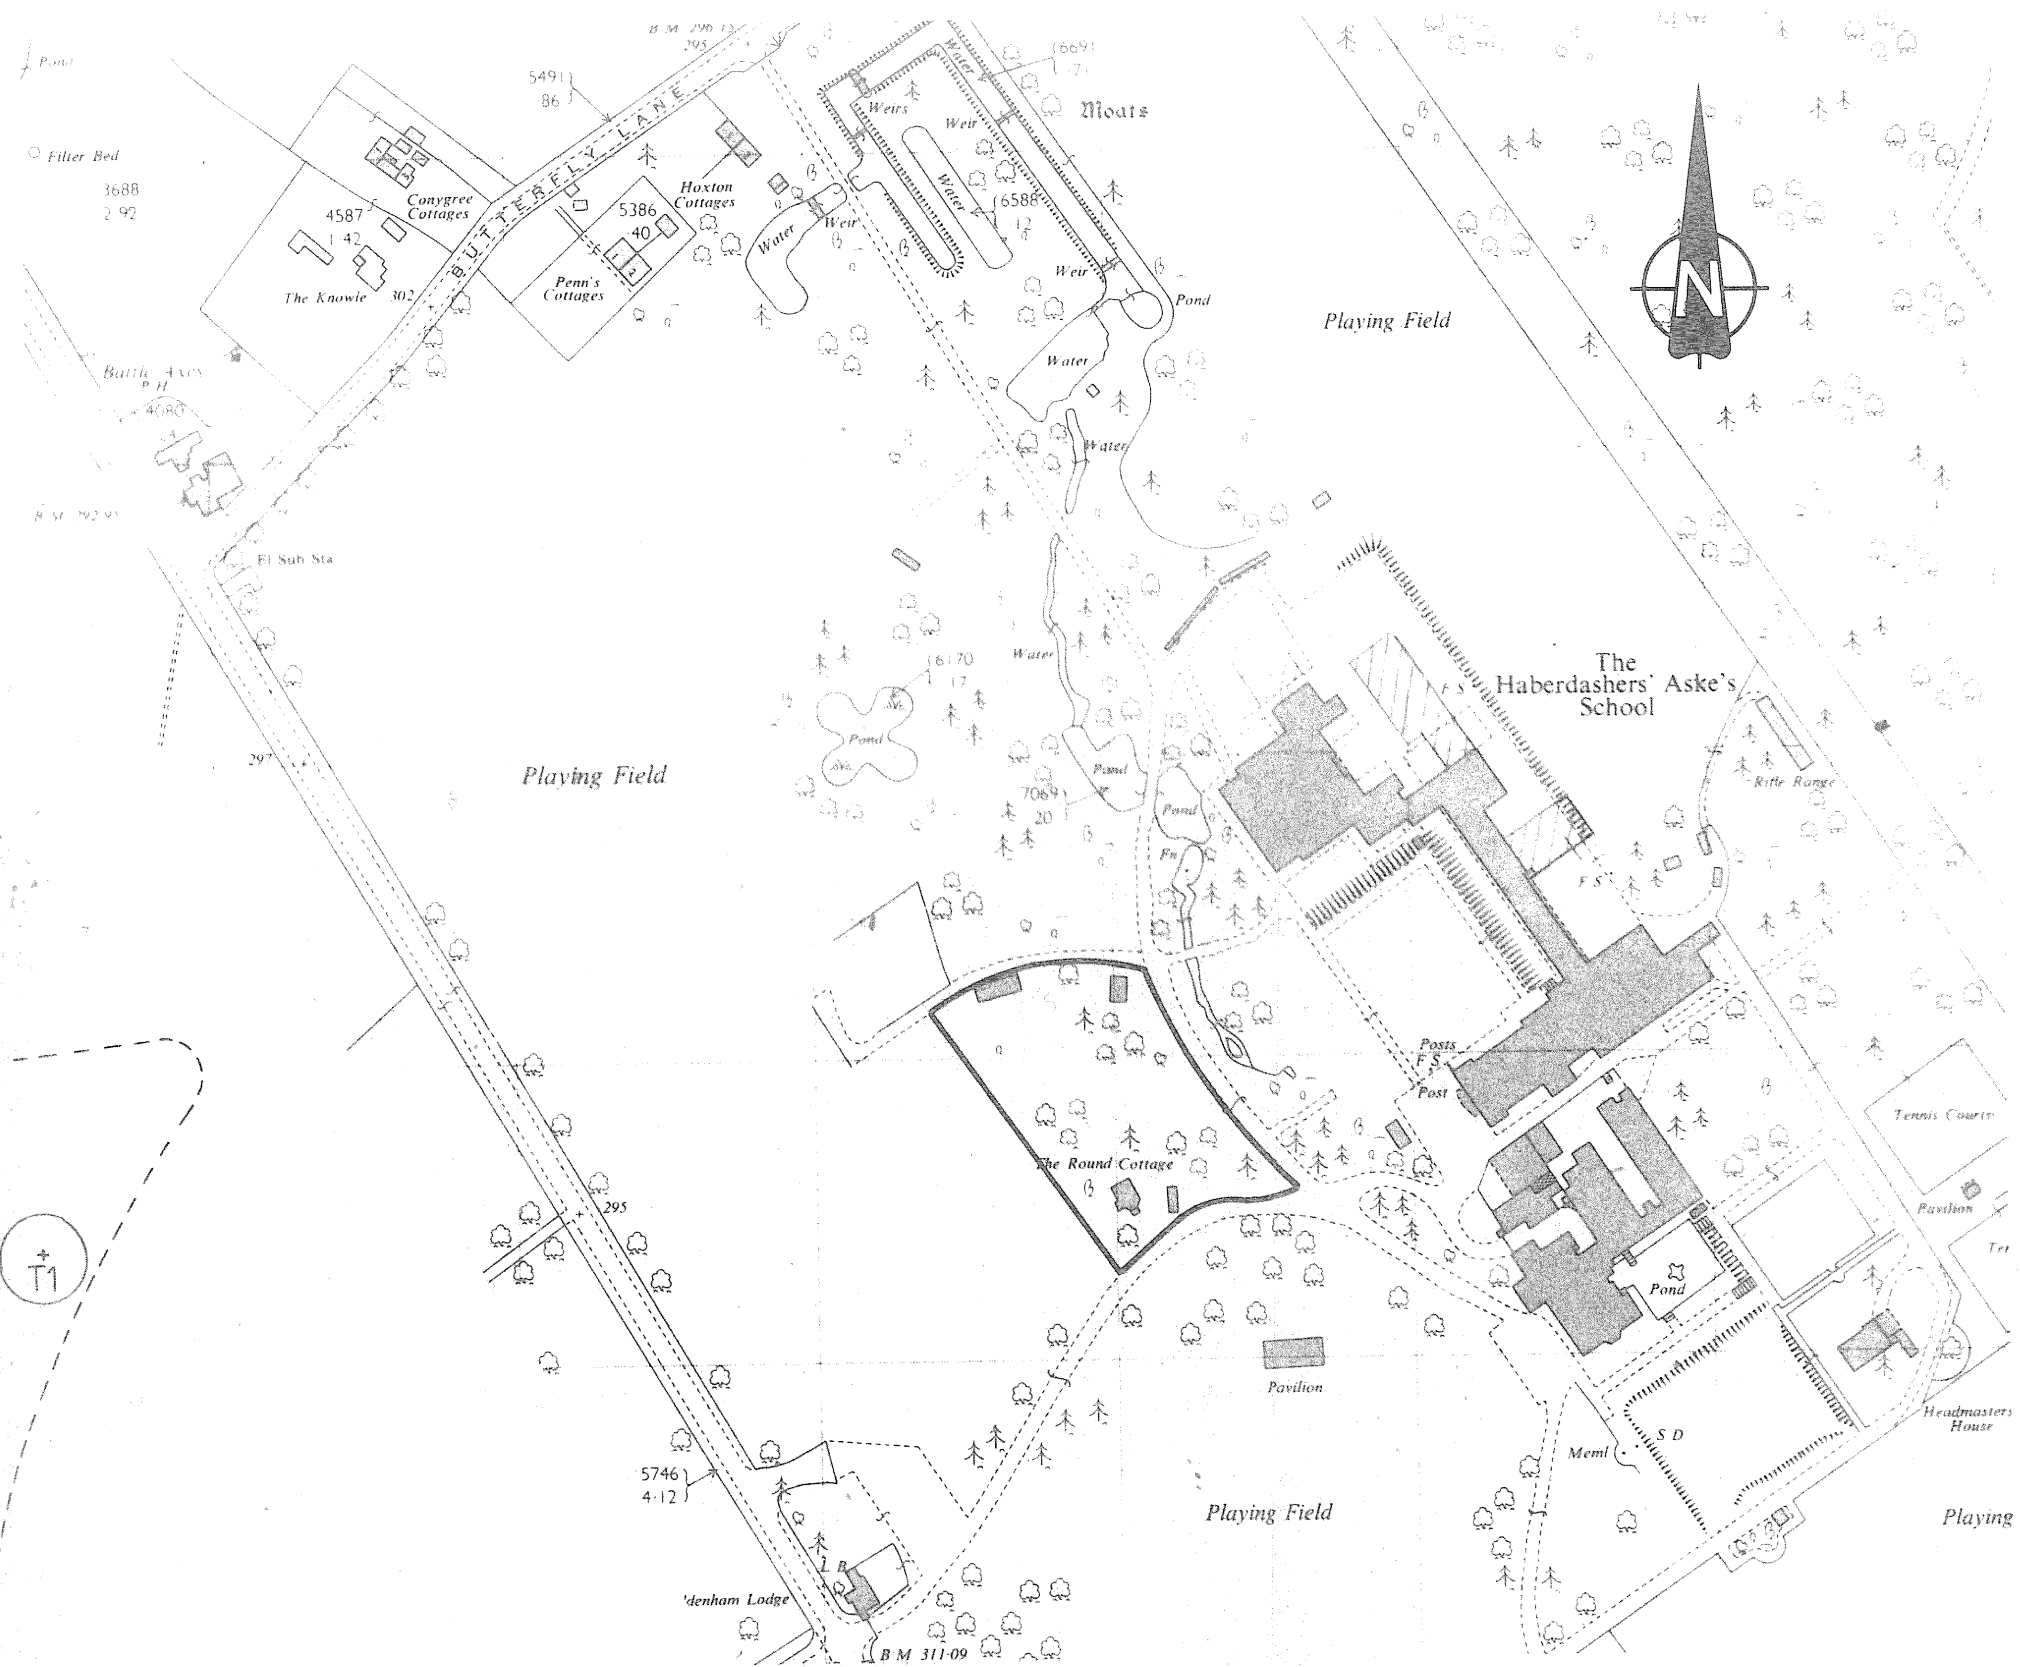

The Hertsmere Borough Council, in exercise of the within written powers conferred upon them in that behalf, hereby confirm the order, subject to the amendments shown in red.

In witness whereof the Common Seal of the Council was hereunto affixed this twenty-sixth day of July 1982 in the presence of

Mayor

Borough Secretary

HERTSMERE BOROUGH COUNCIL

M. C. TURNER B.Sc. C.Eng., M.I.Mun.E.
Borough Technical Services Officer
A. J. WHEELER Dip. T.P. (Lond) M.R.T.P.I.
Principal Development Officer

PLANNING & BUILDING CONTROL

SUBJECT

Tree Preservation Order
No 34/82 (Haberdashers' Aske's School, Aldenham Road, Elstree.)

SCALE	DATE
1:500	26.3.82
DRAWN	CHECKED
P.A.C.	

H.B.C. Ref. No.

H.C.C. Appln. No.

DRAWING No. **TP/301**