


TOWN AND COUNTRY PLANNING ACTS 1971-1974

Plan referred to in

THE HERTSMERE BOROUGH COUNCIL

(HARTSBOURNE AVENUE , BUSHEY HEATH.)

TREE PRESERVATION ORDER No. 54 /1983

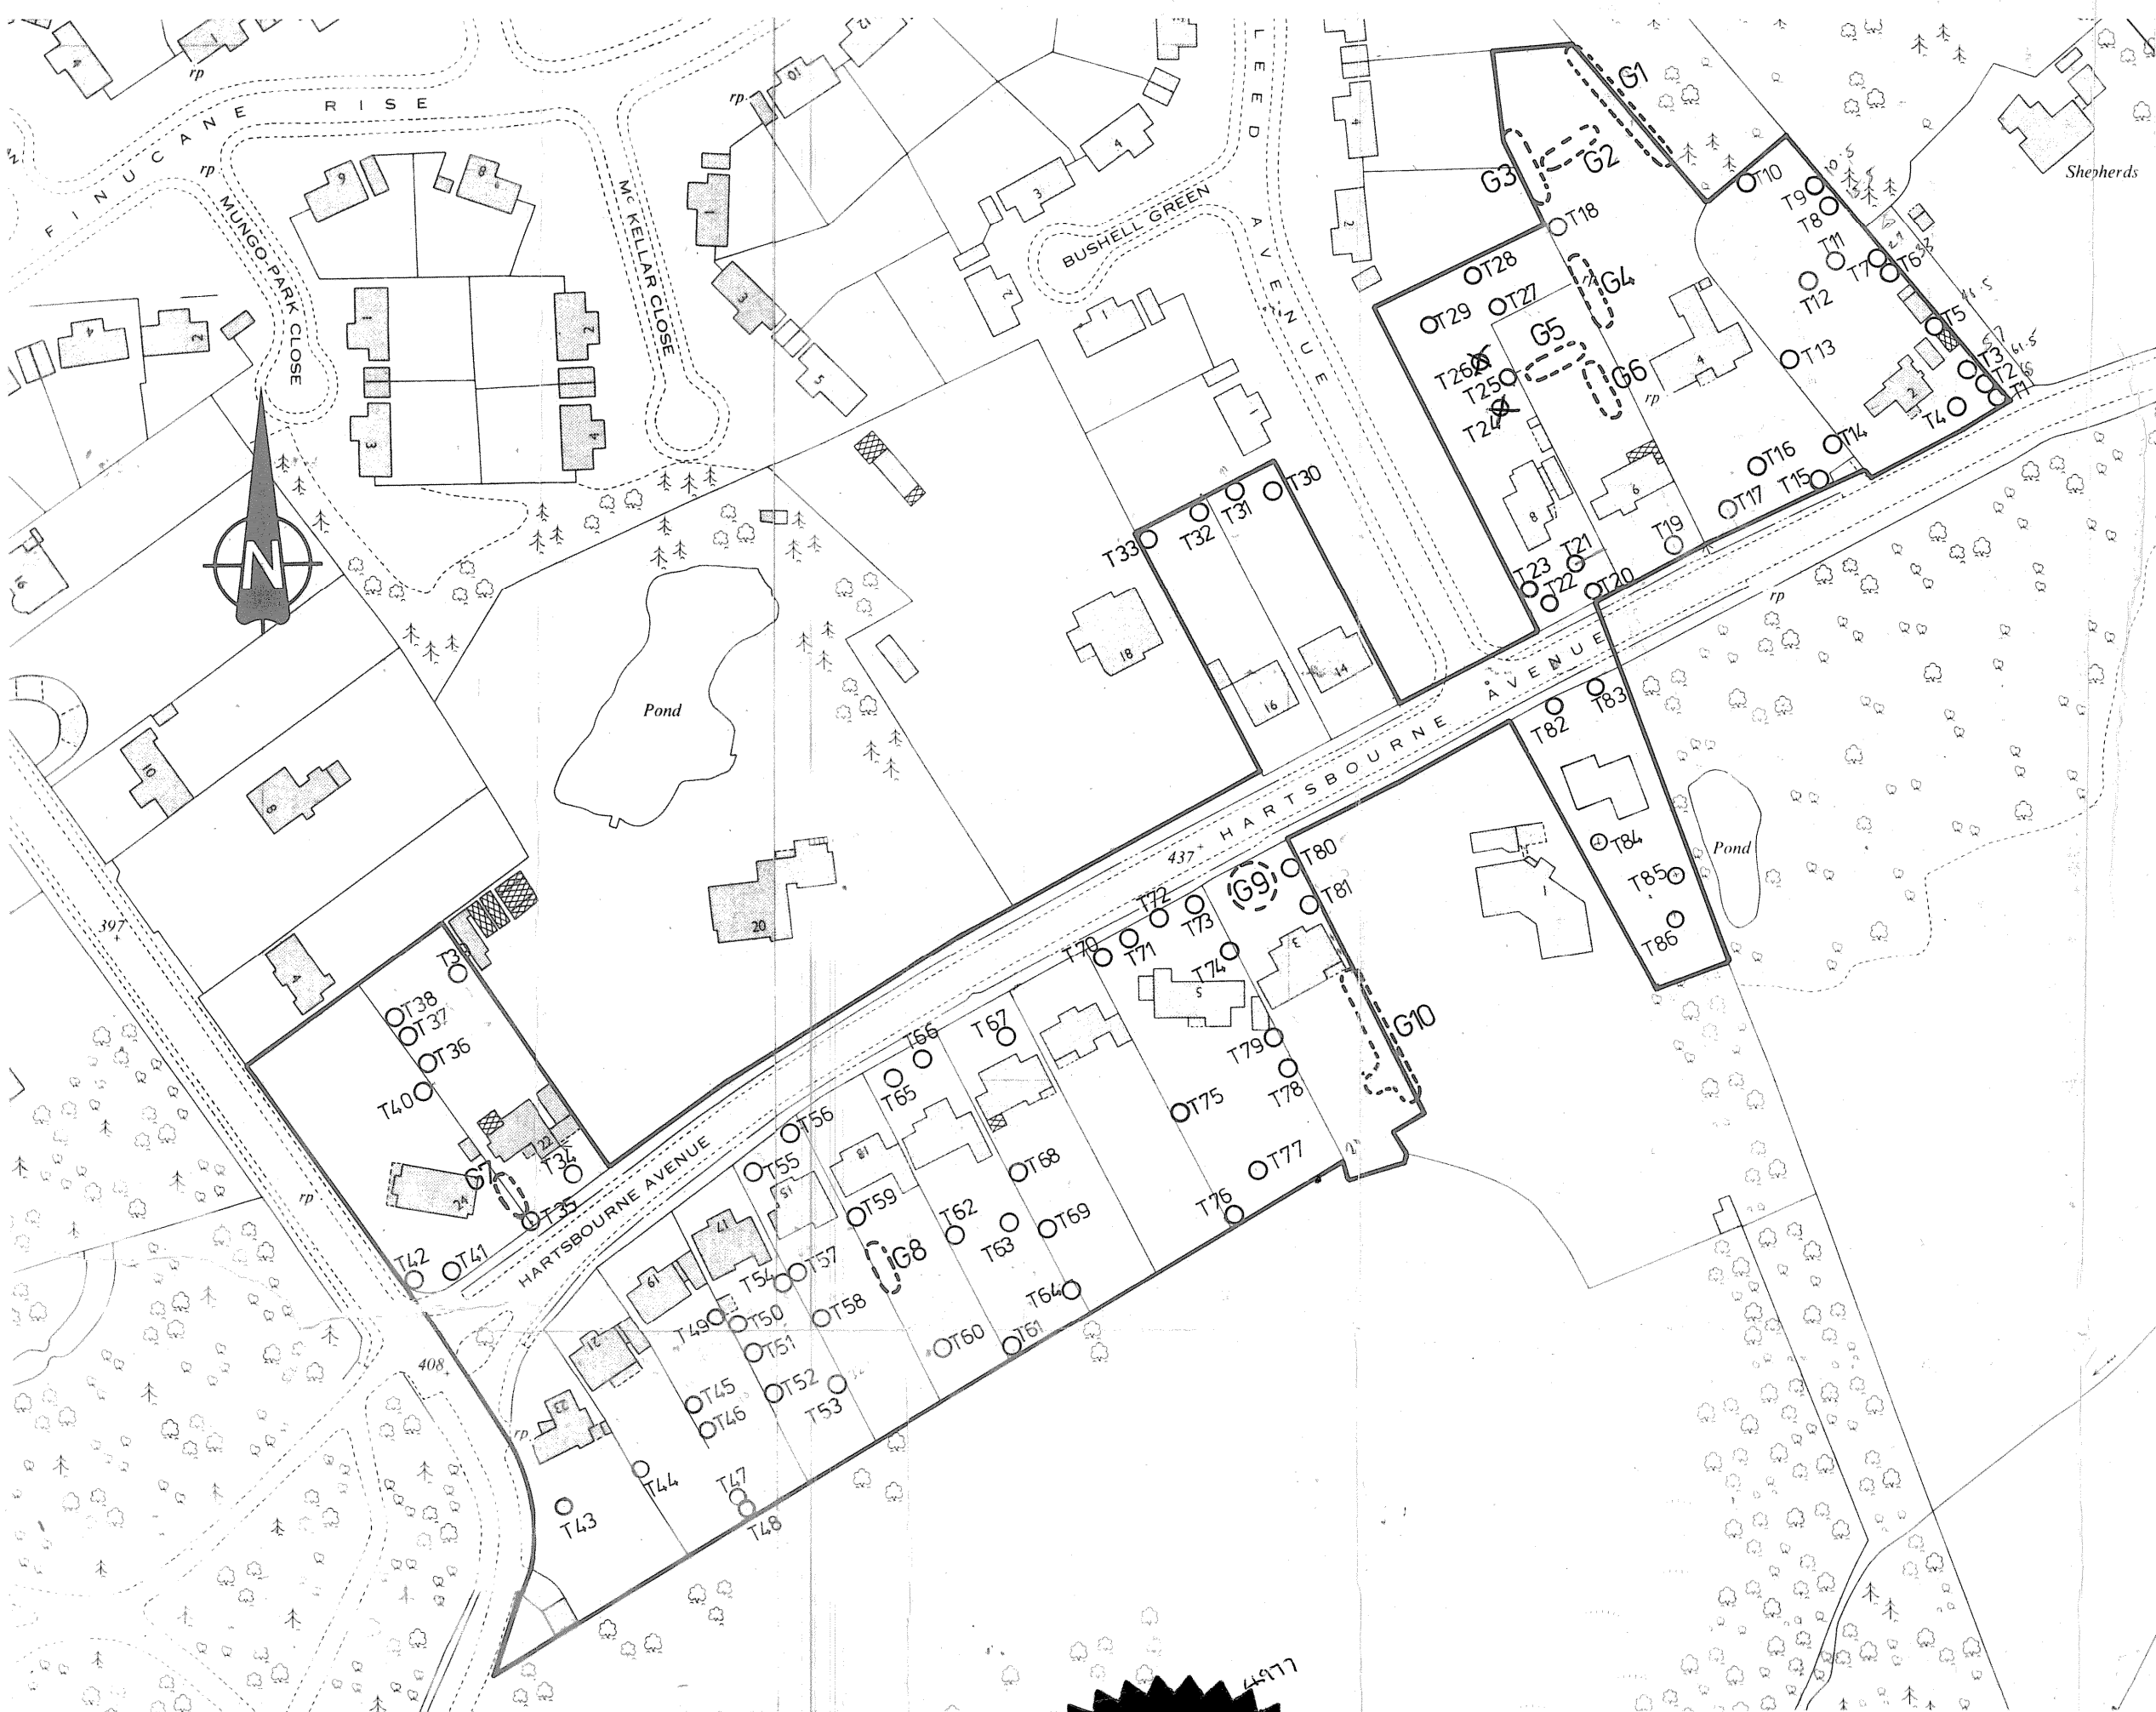

SCHEDULE OF TREES

No.	TYPE
T1	Oak
T2	Horsechestnut
T3	Lime
T4	Holly
T5	Sycamore
T6	Oak
T7	Oak
T8	Pine
T9	Oak
T10	Lime
T11	Hornbeam
T12	Ash
T13	Rowan
T14	Oak
T15	Oak
T16	Horsechestnut
T17	Oak
T18	Hawthorn
T19	Rowan
T20	Rowan
T21	Horsechestnut
T22	Silver Birch
T23	Silver Birch
T24	Acacia
T25	Acacia
T26	Acacia
T27	Willow
T28	Willow
T29	Walnut
T30	Sycamore
T31	Sycamore
T32	Rowan
T33	Rowan
T34	Rhus
T35	Cypressus
T36	Prunus
T37	Beech
T38	Cypressus
T39	Silver Birch
T40	Cherry
T41	Thorn
T42	Thorn
T43	Willow
T44	Hawthorn
T45	Cypressus
T46	Cedar
T47	Cypressus
T48	Pine
T49	Willow
T50	Holly
T51	Pine
T52	Pine
T53	Pine
T54	Holly
T55	Cherry
T56	Copper Beech
T57	Cypressus
T58	Cypressus
T59	Cypressus

SCHEDULE OF TREES

No.	TYPE
T60	Oak
T61	Poplar
T62	Cedar
T63	Cedar
T64	Hornbeam
T65	Cypressus
T66	Cypressus
T67	Cypressus
T68	Cypressus
T69	Cypressus
T70	Prunus
T71	Rowan
T72	Rowan
T73	Prunus
T74	Cherry
T75	Cherry
T76	Pine
T77	Acacia
T78	Willow
T79	Sycamore
T80	Cypressus
T81	Cherry
T82	Sweet Chestnut
T83	Cypressus
T84	Rowan
T85	Holly
T86	Oak
G1.	14 No. Cypressus
G2.	4 No. Cypressus
G3.	4 No. Cypressus
G4.	8 No. Cypressus 1 No. Cherry
G5.	4 No. Cypressus
G6.	3 No. Cypressus
G7.	4 No. Cypressus 1 No. Silver Birch
G8.	3 No. Beech
G9.	2 No. Pine 7 No. Cypressus
G10.	5 No. Cypressus 1 No. Cherry 1 No. Prunus 1 No. Holly 1 No. Sycamore

THE COMMON SEAL OF HERTSMERE BOROUGH COUNCIL
WAS HEREUNTO AFFIXED THIS eighth DAY OF

SEPTEMBER 1983 IN THE PRESENCE OF:

J. E. Fielding MAYOR

BOROUGH SECRETARY

The Hertsmeare Borough Council in exercise of the within written powers conferred upon them in that behalf, hereby confirm the order subject to the amendments shown in red.

In witness whereof the Common Seal of the Council was hereunto affixed this ninth day of March 1984 in the presence of:-

J. E. Fielding Mayor

Borough Secretary

HERTSMERE
BOROUGH COUNCIL
Civic Offices
Elstree Way
Borehamwood
Herts WD6 1WA

SCALE 1:1250 DATE 6-9-83

DRAWN P.A.C. CHECKED S.L.

DRAWING No. TP/324