


TOWN AND COUNTRY PLANNING ACTS 1971-1974

Plan referred to in

THE HERTSMERE BOROUGH COUNCIL
(LAND BETWEEN MIMMS HALL ROAD, MUTTON LANE,
AND CAMBRIDGE DRIVE POTTERS BAR.)

TREE PRESERVATION ORDER No. 93 /1985

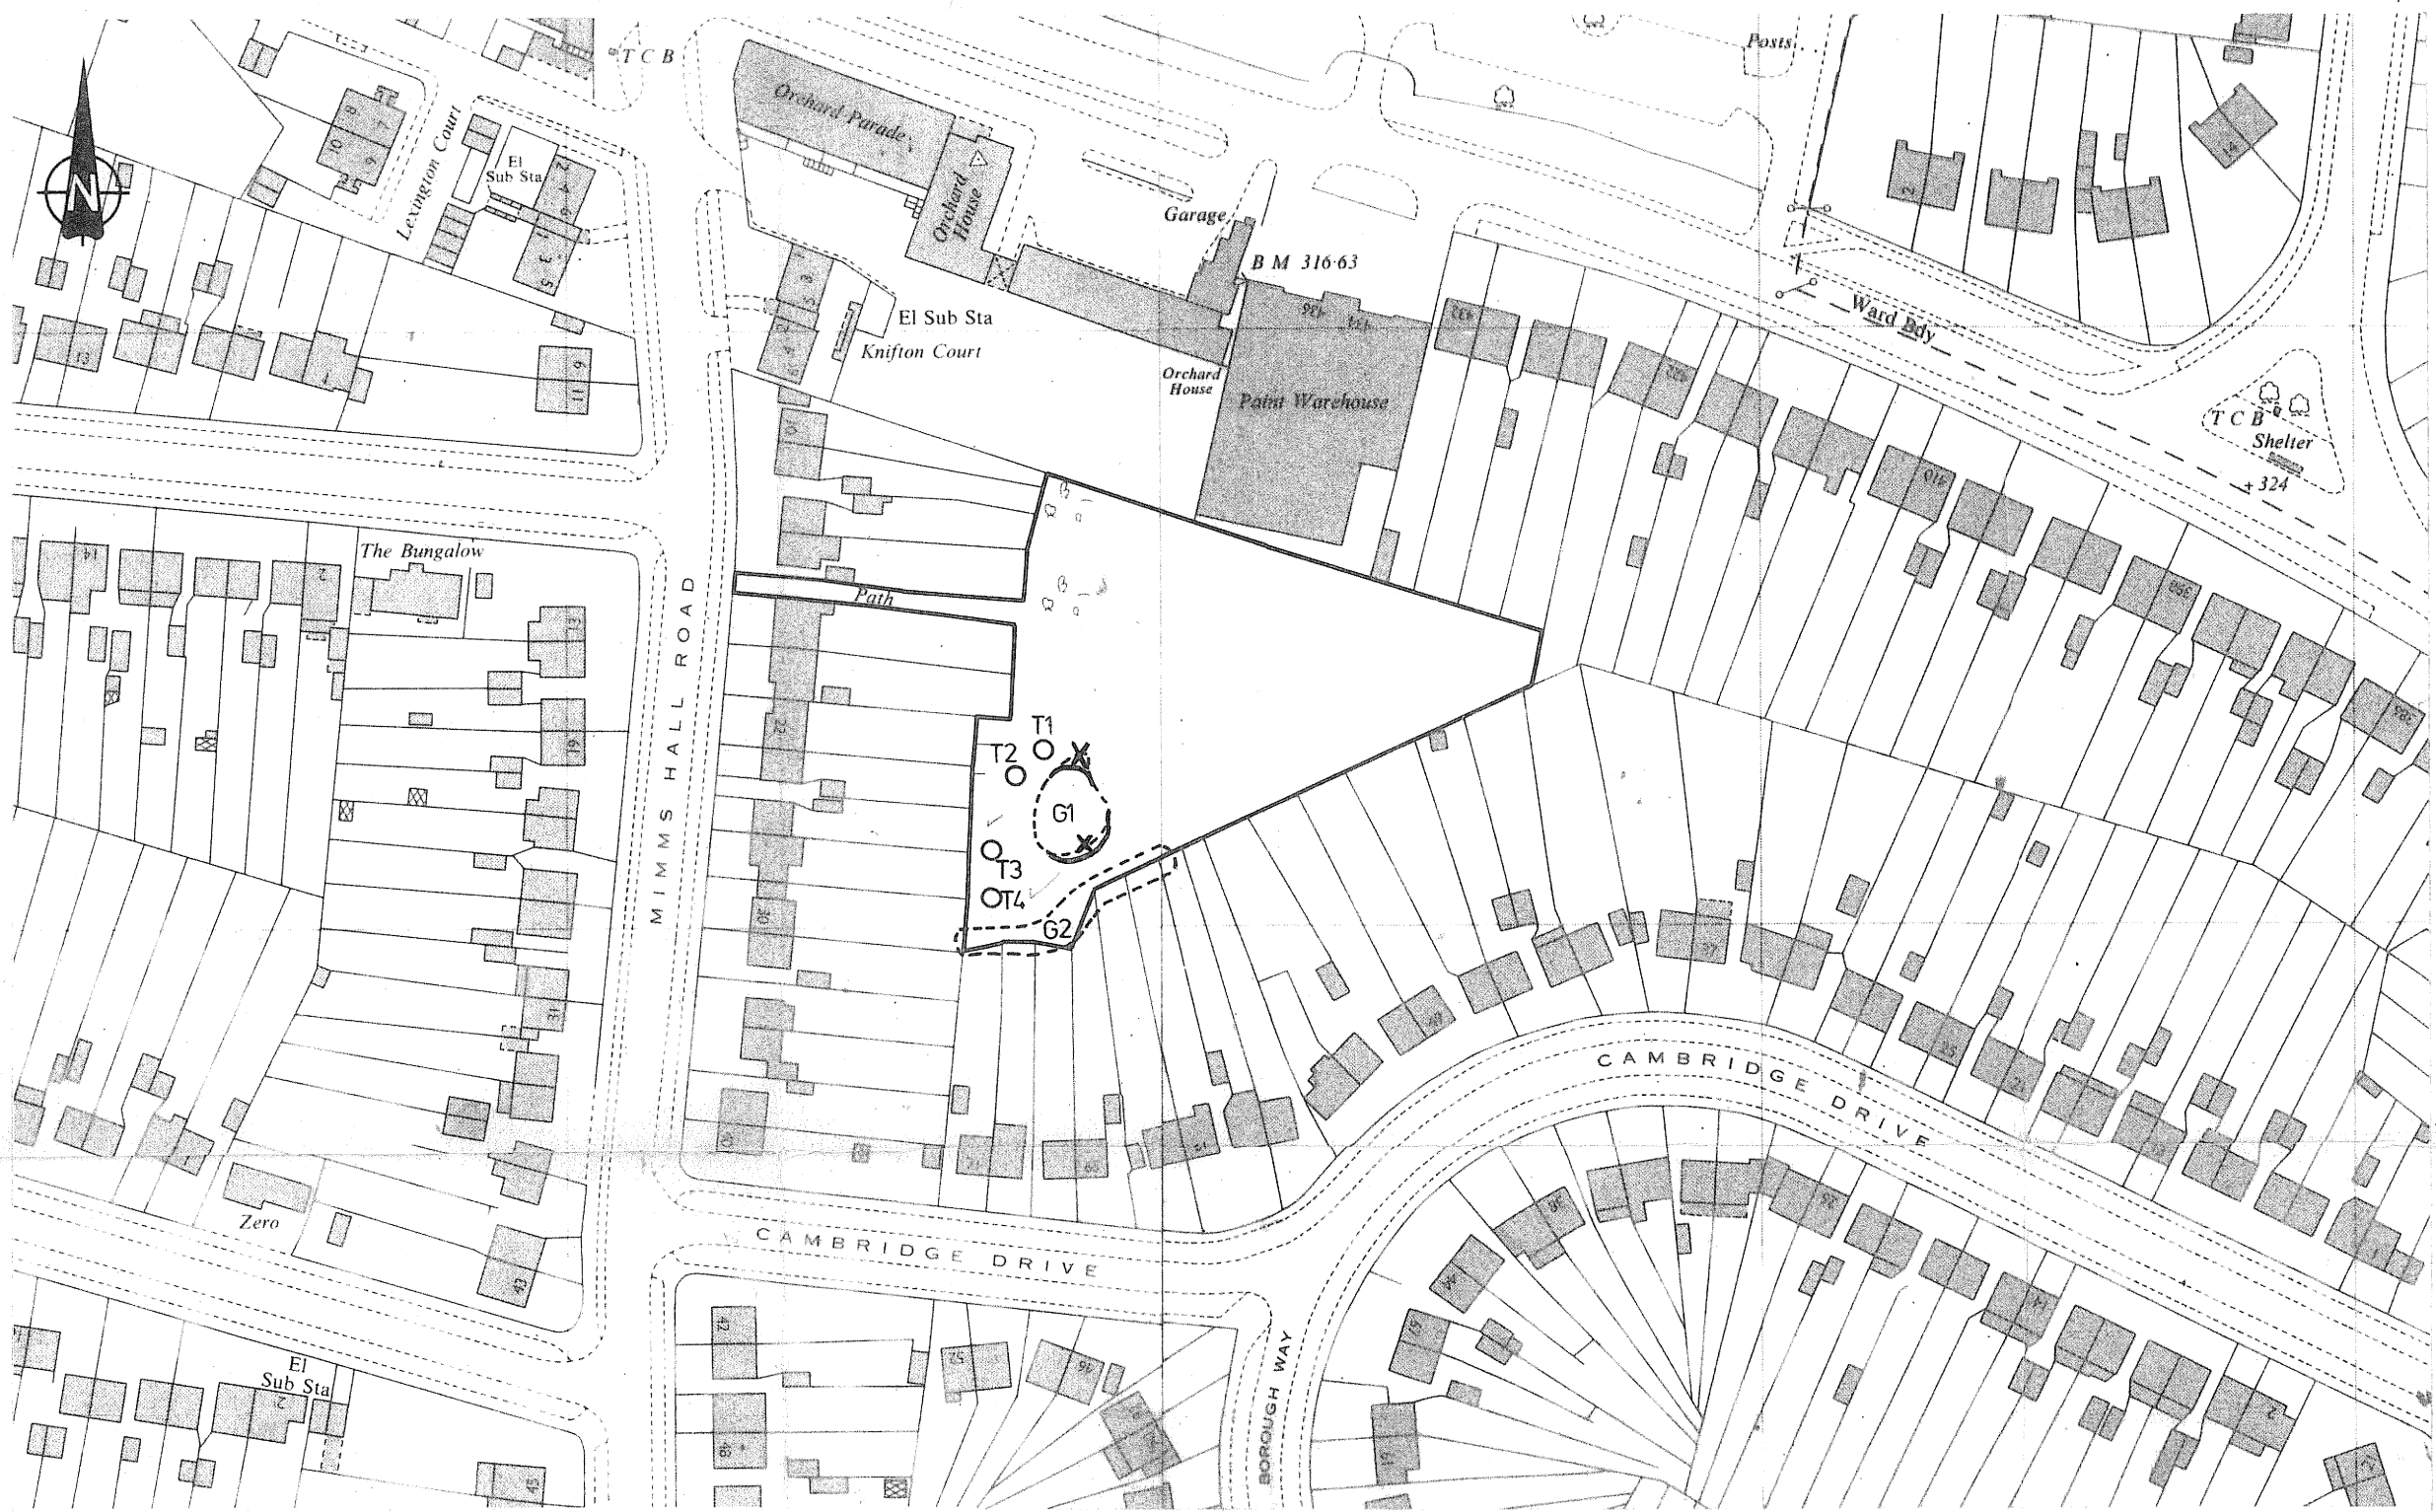

The Hertsmere Borough Council, in exercise of the within written powers conferred upon it in that behalf, hereby confirms the Order subject to the amendment shown in red.

In Witness whereof the Common Seal of the Council was hereunto affixed this Twenty-Ninth day of October 1985 in the presence of

(Signed) I.C. HARDING MAYOR

(Signed) T.G. LORAIN ADMINISTRATOR

THE COMMON SEAL OF HERTSMERE BOROUGH COUNCIL
WAS HEREUNTO AFFIXED THIS SECOND DAY OF
AUGUST 1985 IN THE PRESENCE OF:

(Signed) A.G.WATSON DEPUTY MAYOR

(Signed) T.G.LORAIN ADMINISTRATOR

SCHEDULE OF TREES

No.	TYPE
T1	Oak
T2	Oak
T3	Willow
T4	Oak
G1	Group Consisting of 10 Oak
G2	Group Consisting of 7 Ash and 1 Silver Birch

MAP REF T 2401 -L0164

HERTSMERE
BOROUGH COUNCIL
Civic Offices
Elstree Way
Borehamwood
Herts WD6 1WA

SCALE 1:1250	DATE 2.7.85
DRAWN P.A.C	CHECKED R.D.L
DRAWING No.	TP / 376

Reproduced from the Ordnance Survey map with the permission of the Controller of Her Majesty's Stationery Office. Crown Copyright reserved.