

TOWN AND COUNTRY PLANNING ACTS 1971-1974


Plan referred to in

THE HERTSMERE BOROUGH COUNCIL
(LAND REAR OF 29-31, COLDHARBOUR LANE,
BUSHEY)
TREE PRESERVATION ORDER No. 134 /1987

SCHEDULE OF TREES	
No.	TYPE
T1	SILVER BIRCH
T2	ASH
T3	CYPRESS
T4	SILVER BIRCH
T5	LIME
T6	ASH
T7	SCOTS PINE
T8	SILVER BIRCH
T9	SCOTS PINE

G1 CONSISTING OF
1N° SILVER BIRCH &
7N° BEECH.

G2 CONSISTING OF
3N° BEECH.

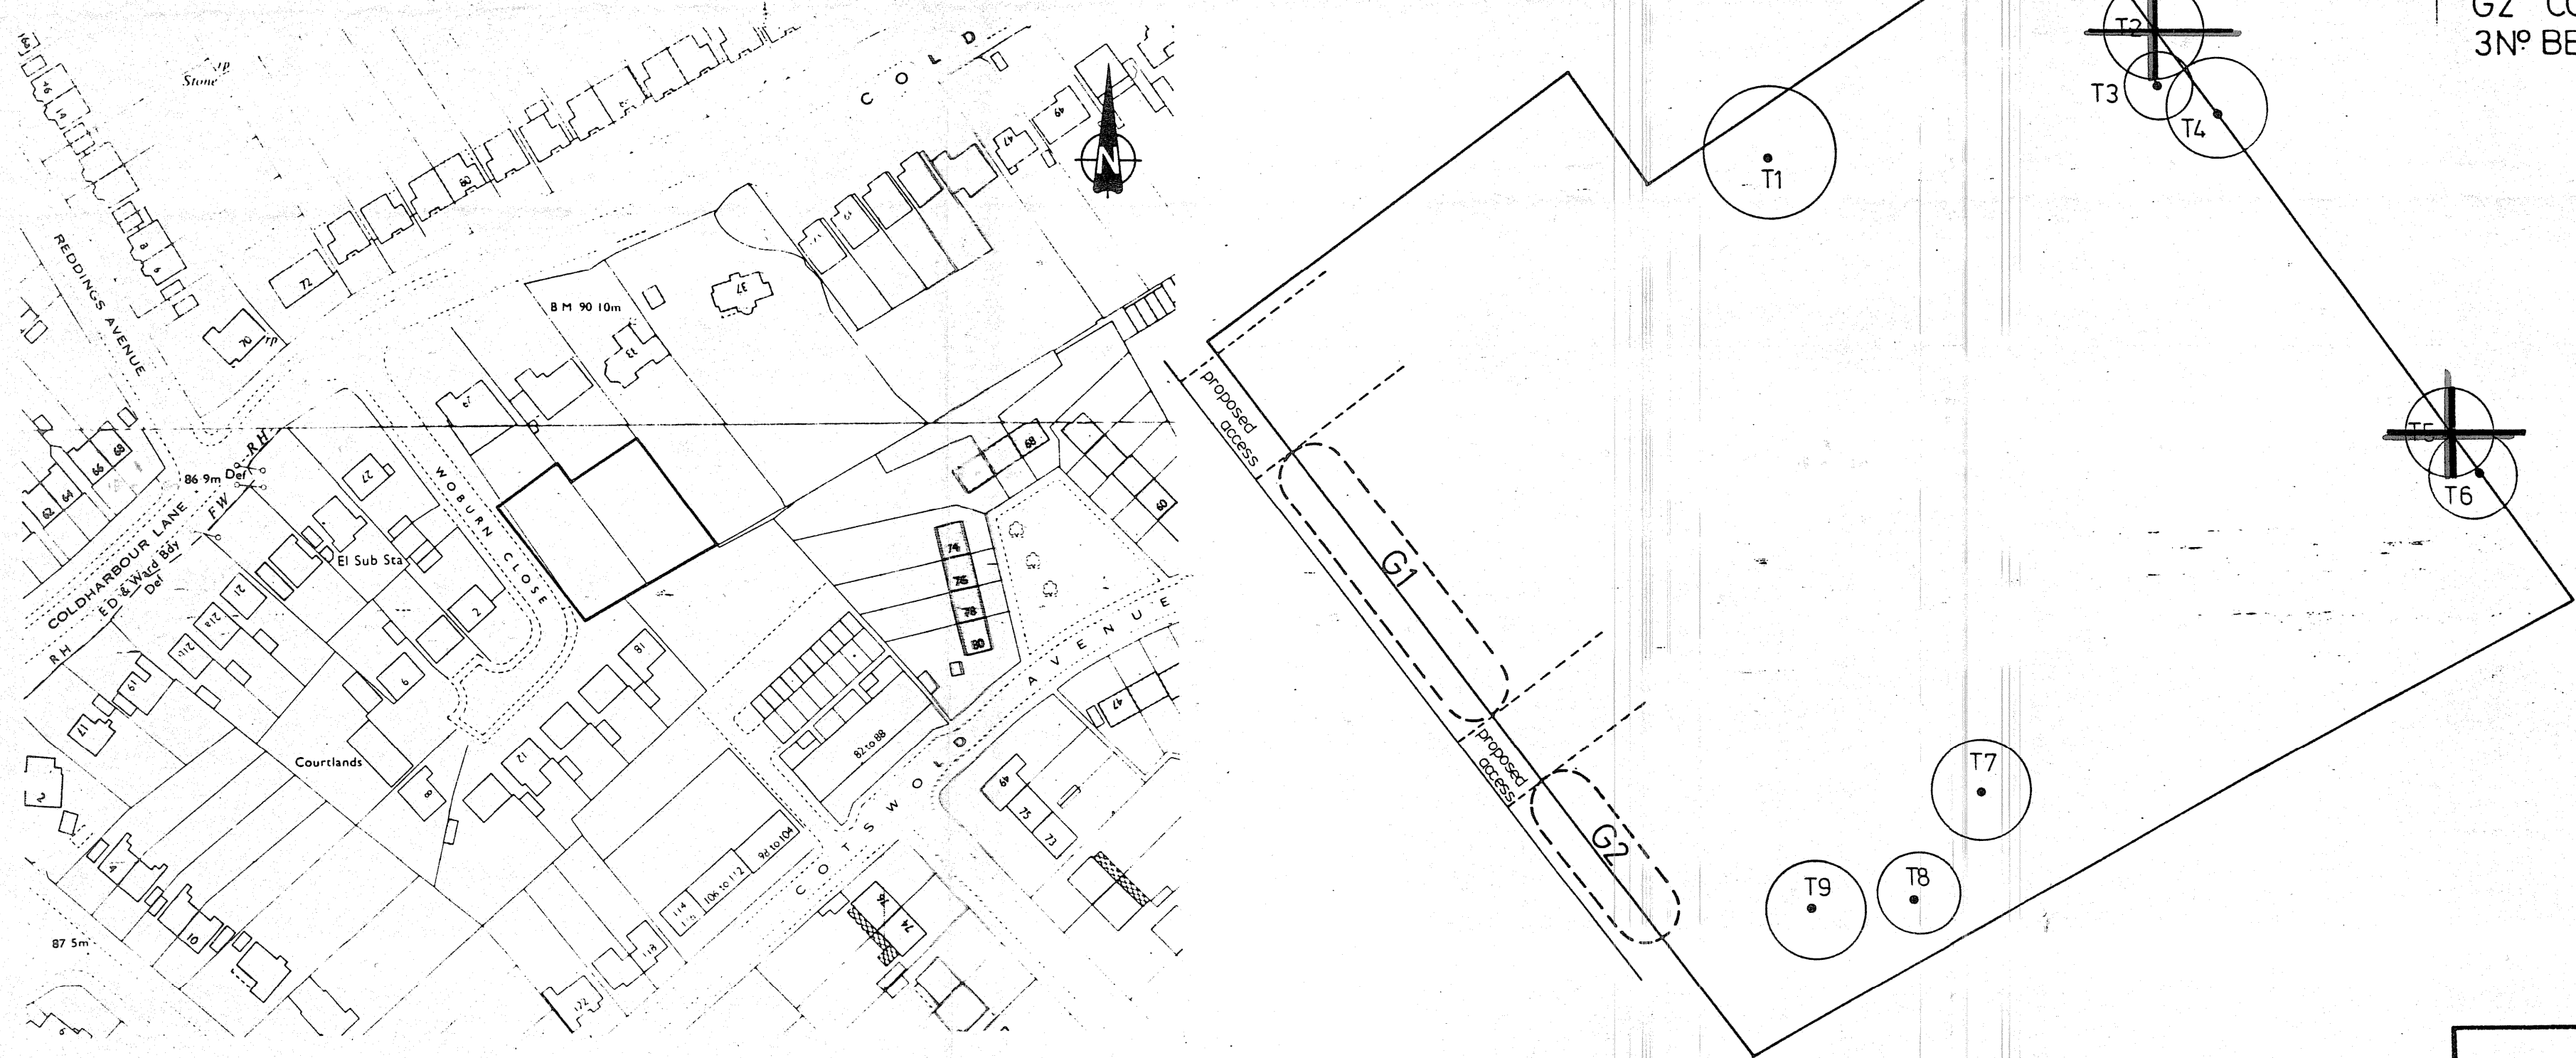

THE COMMON SEAL OF HERTSMERE BOROUGH COUNCIL
WAS HEREUNTO AFFIXED THIS TWENTY-SIXTH DAY OF
JUNE 1987 IN THE PRESENCE OF:

(Signed) G.A.NUNN MAYOR
(Signed) R.T.LEWIS SOLICITOR

The HERTSMERE BOROUGH COUNCIL, in exercise of the within written powers conferred upon it
in that behalf, hereby confirms the Order, subject to the Amendments shown in red.

In witness whereof the Common Seal
of the Council was hereunto affixed
this twenty first day of December 1987
in the presence of

(signed) G.A. NUNN
(Mayor)
(signed) R.T. LEWIS
(Solicitor)

Reproduced from the Ordnance Survey map with the permission of the
Controller of Her Majesty's Stationery Office. Crown Copyright
reserved.

HERTSMERE
BOROUGH COUNCIL
Civic Offices
Elstree Way
Borehamwood
Herts WD6 1WA

SCALE	1: 200	DATE	16.6.87
DRAWN	P.A.C	CHECKED	D.H
DRAWING No. TP/438			