


TOWN AND COUNTRY PLANNING ACTS 1971-1974

Plan referred to in

THE HERTSMERE BOROUGH COUNCIL
(17-21 CHILTERN AVE. 24,26 KING GEORGE AVE.)
BUSHEY.)

TREE PRESERVATION ORDER No. 164 /1988

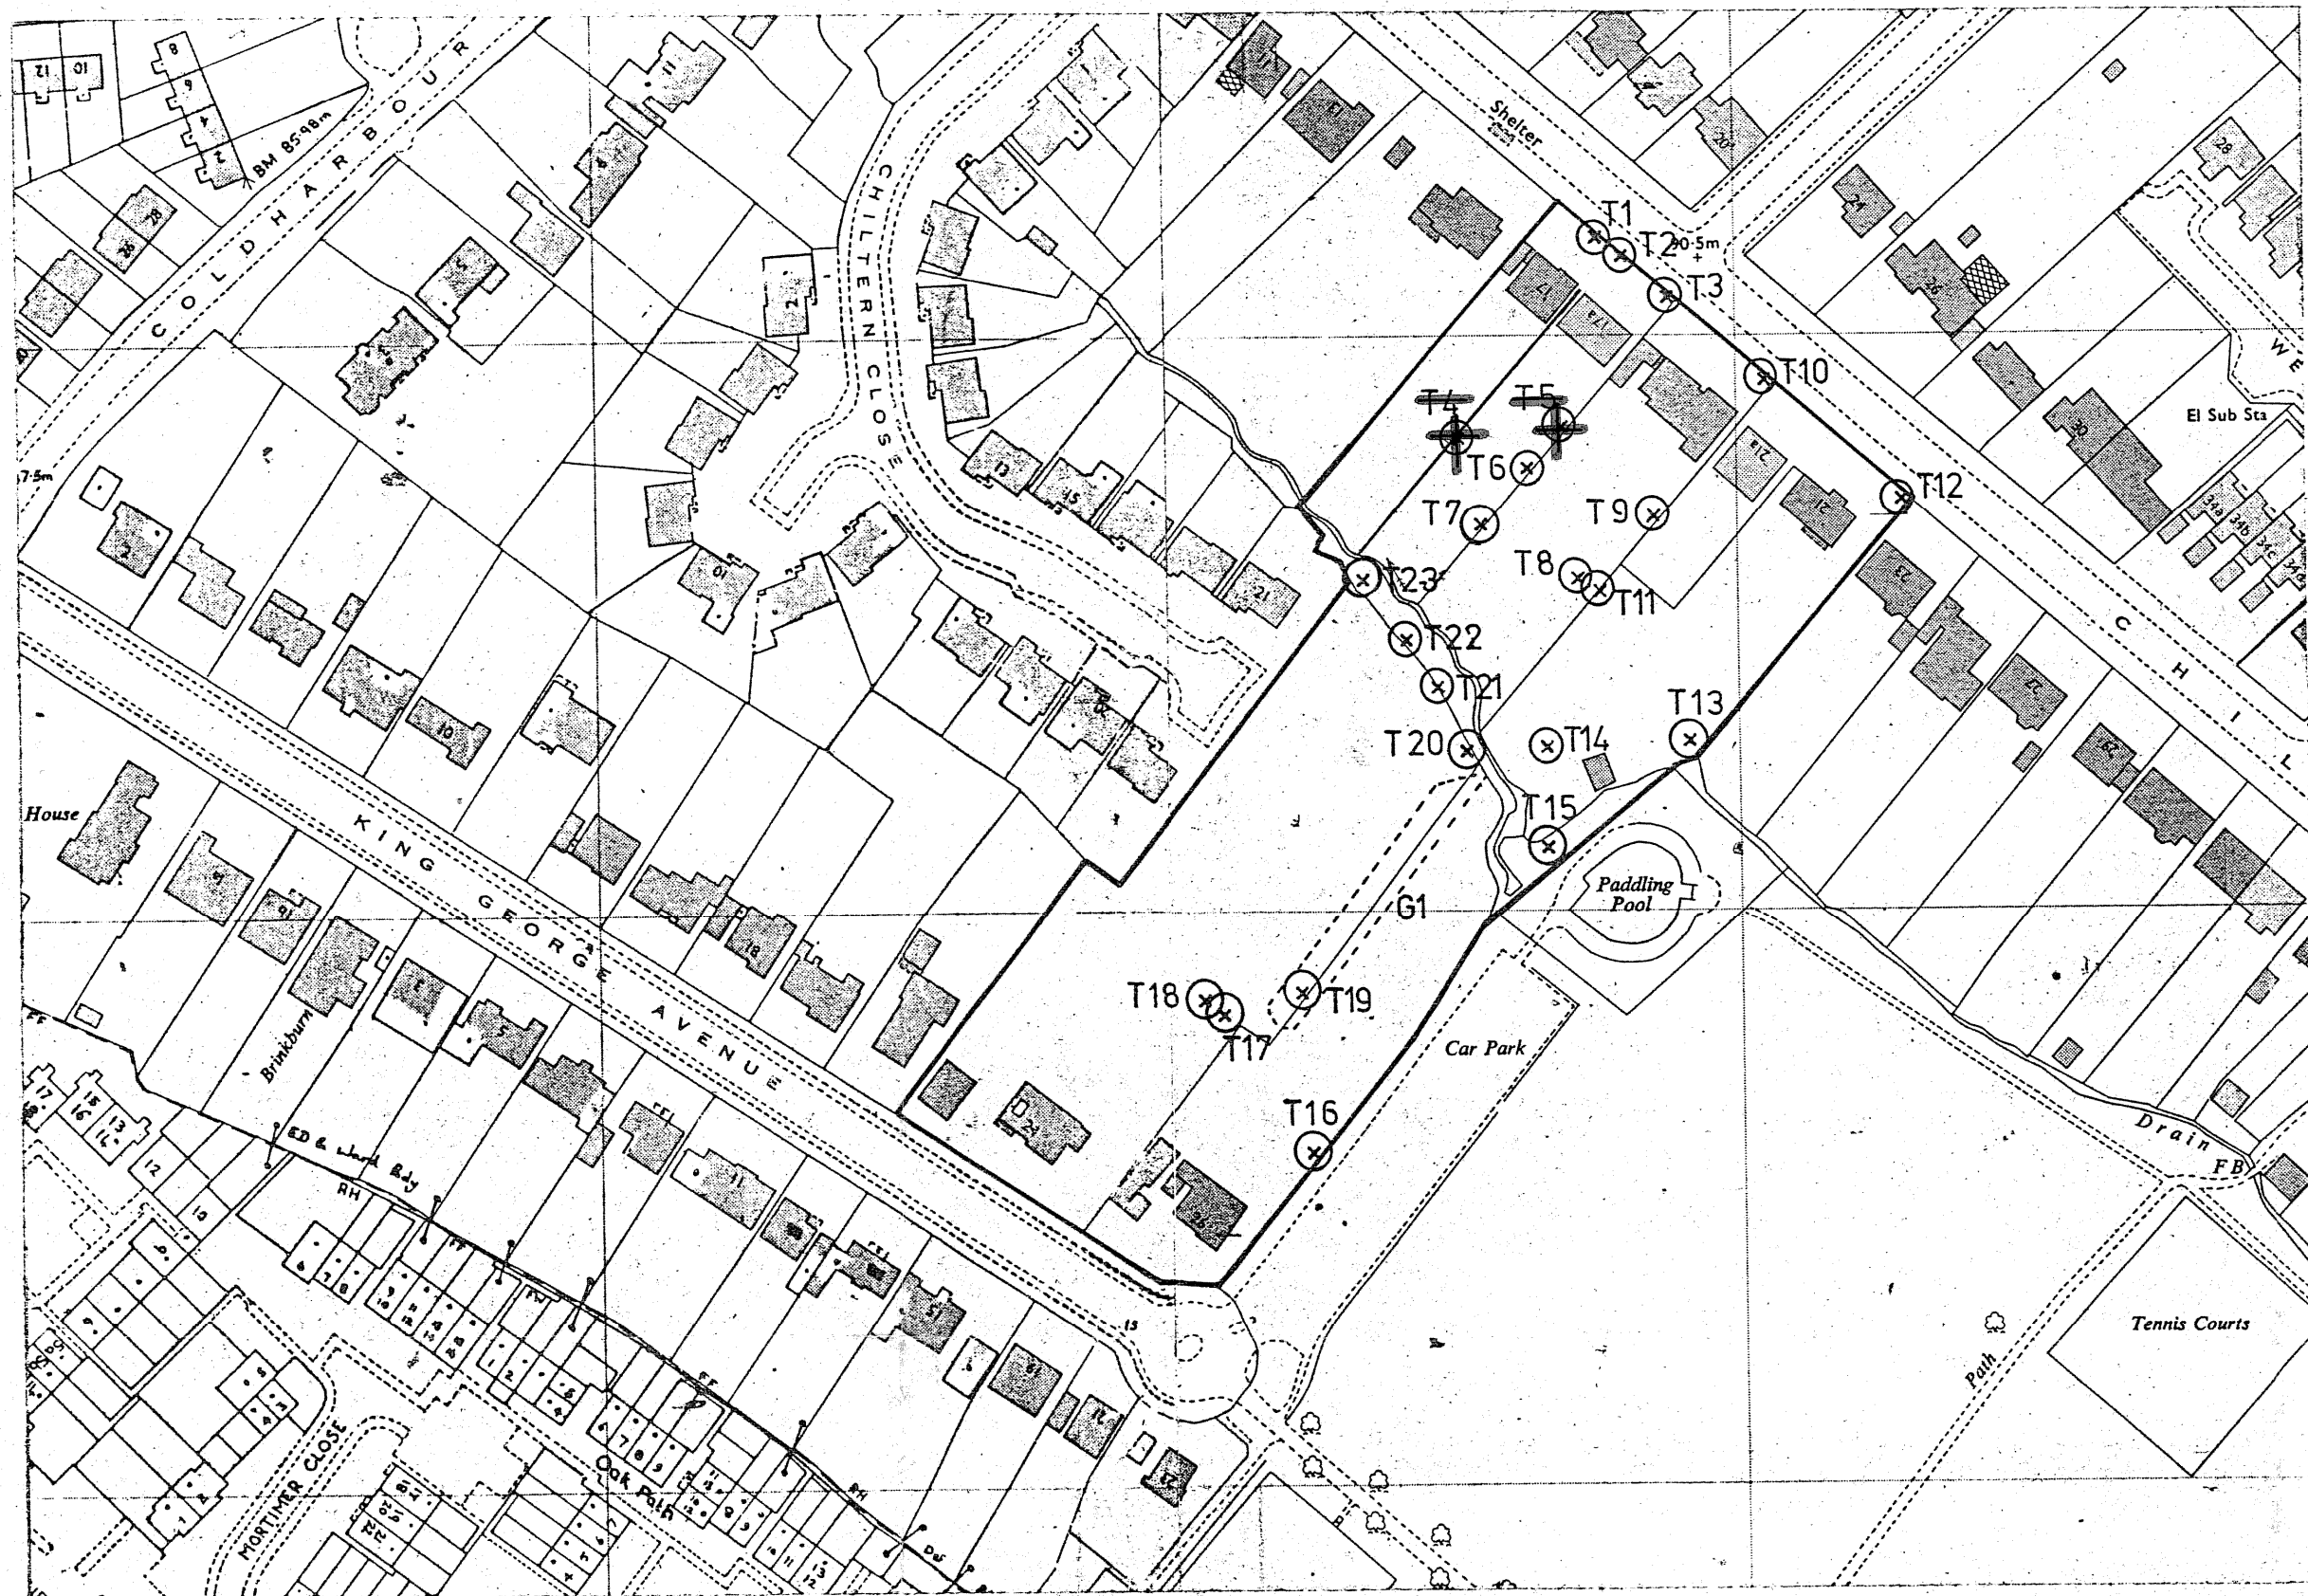

SCHEDULE OF TREES

No.	TYPE
T1	BIRCH
T2	BIRCH
T3	BIRCH
T4	WILLOW
T5	LARCH
T6	COPPER BEECH
T7	FIELD MAPLE
T8	BLUE SPRUCE
T9	BIRCH
T10	HORSE CHESTNUT
T11	NORWAY SPRUCE
T12	BEECH
T13	LIME
T14	OAK
T15	OAK
T16	OAK
T17	MAPLE
T18	MAPLE
T19	CYPRESS
T20	OAK
T21	OAK
T22	ASH
T23	OAK
G1	CONSISTING OF 37 BEECH

MAP REF. T140-Q 952

HERTSMERE
BOROUGH COUNCIL
Civic Offices
Elstree Way
Borehamwood
Herts WD6 1WA

THE COMMON SEAL OF HERTSMERE BOROUGH COUNCIL
WAS HEREUNTO AFFIXED THIS TWENTY FIFTH DAY OF
JULY 1988 IN THE PRESENCE OF:

MAYOR

SOLICITOR

The Hertsmere Borough Council in exercise of the within written powers
conferred upon it in that behalf, hereby confirms the Order subject to
amendments shown in red.


In witness where of the Common Seal of the Council was hereunto affixed
this Twenty First day of December 88 in the Presence of

Signed

[Signature]
Mayor

Signed

[Signature]
Solicitor

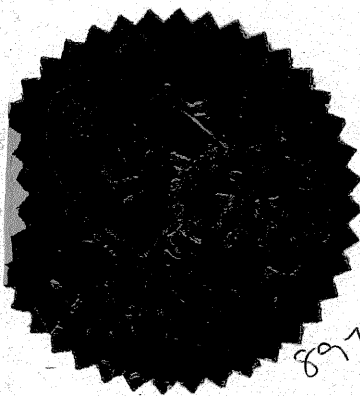

Reproduced from the Ordnance Survey map with the permission of the
Controller of Her Majesty's Stationery-Office. Crown Copyright
reserved.

SCALE	1 : 1250	DATE	13/7/88
DRAWN	S.D.M	CHECKED	S.J
DRAWING No.	TP471		