


# TOWN AND COUNTRY PLANNING ACT 1990

Plan referred to in

THE HERTSMERE BOROUGH COUNCIL  
( 2 & 4 THATCHED COTTAGES WOODHALL LANE )  
SHENLEY )

TREE PRESERVATION ORDER No. 259 /19 92.

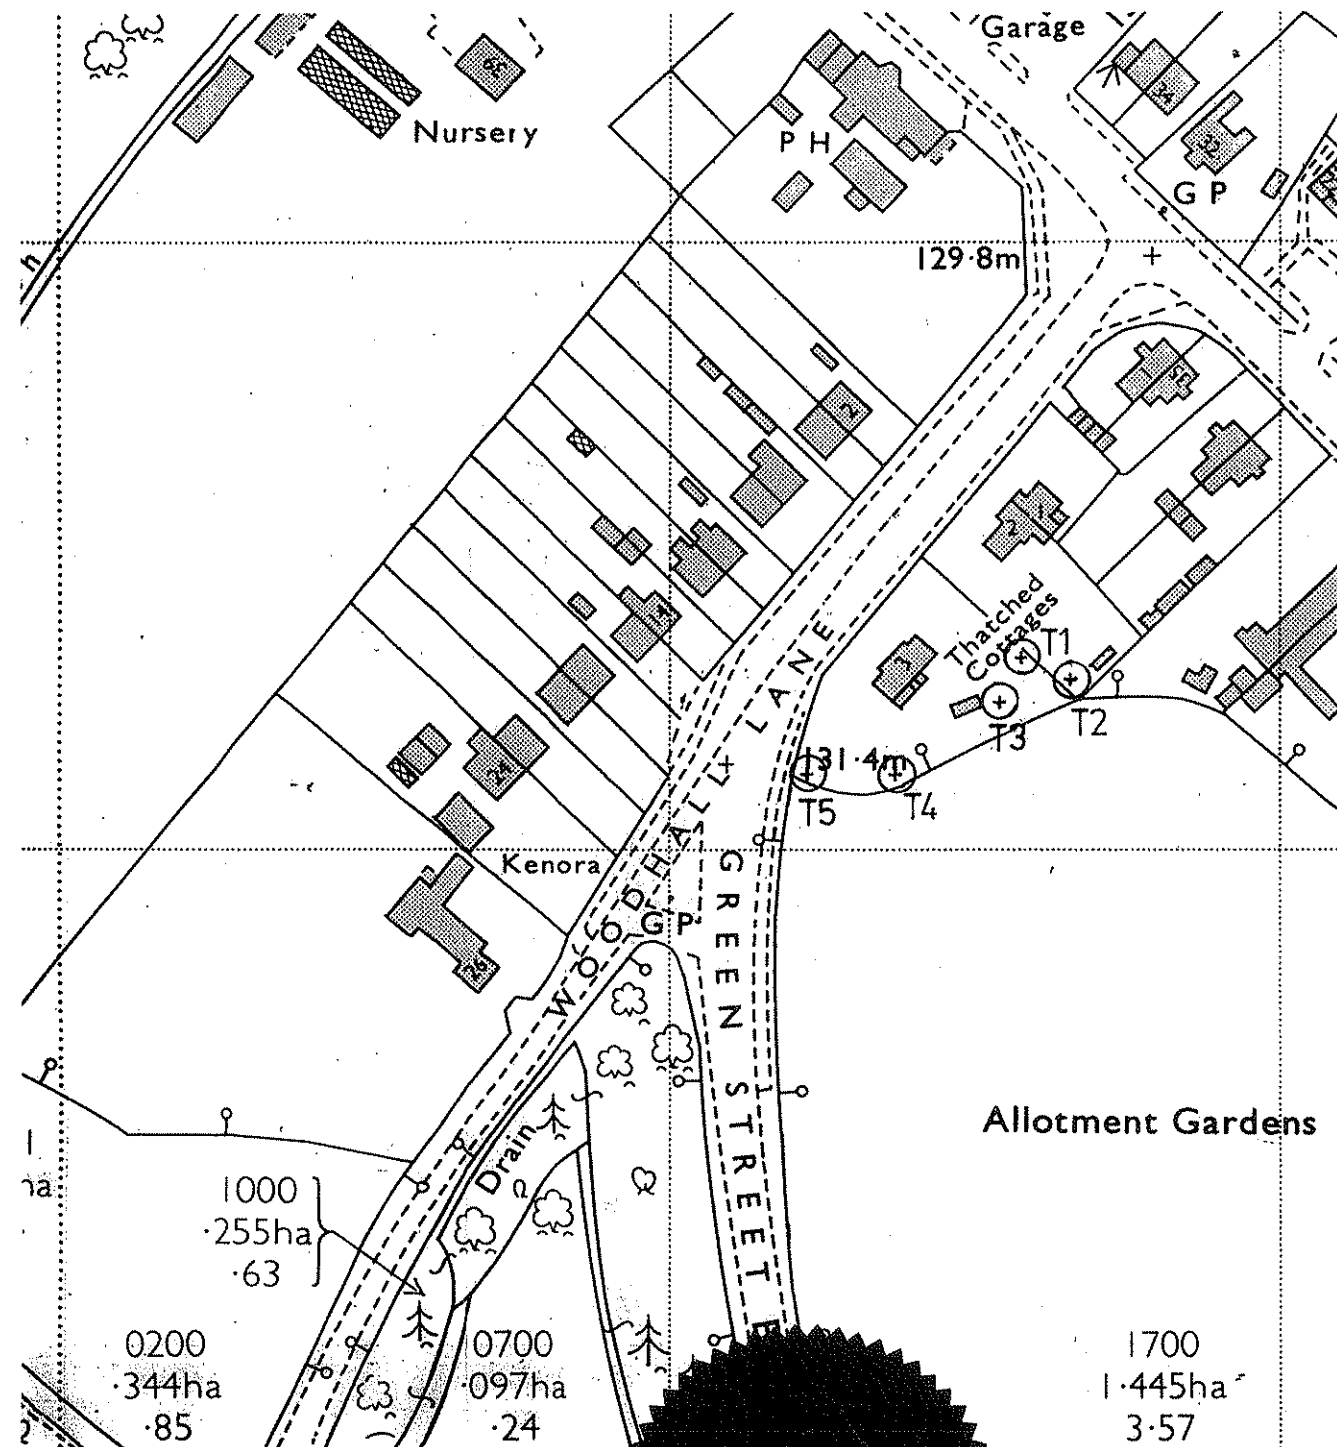

This Order was VARIED by  
Hertsmere Borough Council  
as indicated on the Attached Plan.

on the TWENTY SEVENTH day  
of SEPTEMBER in the year 2005

THE COMMON SEAL OF HERTSMERE BOROUGH COUNCIL  
WAS HEREUNTO AFFIXED THIS TWENTY FIRST DAY OF  
OCTOBER 1992. IN THE PRESENCE OF:

*Mr. G. J. ...*  
BOROUGH SECRETARY

## SCHEDULE OF TREES

No.	TYPE
T1	PINE
T2	"
<del>T3</del>	<del>"</del> REMOVED.
T4	"
T5	"

HERTSMERE  
BOROUGH COUNCIL  
Civic Offices  
Elstree Way  
Borehamwood  
Herts WD6 1WA

SCALE 1:1250 DATE 16/10/92

DRAWN S.D.M. CHECKED

DRAWING No. TP 580

Reproduced from the Ordnance Survey map with the permission of the  
Controller of Her Majesty's Stationery Office. Crown Copyright  
reserved.