


# TOWN AND COUNTRY PLANNING (TREES) REGULATIONS 1999

Plan referred to in *street*  
 THE HERTSMERE (West Herts College, William Way, Bushey, Herts)  
 TREE PRESERVATION ORDER No 1092 / 2003

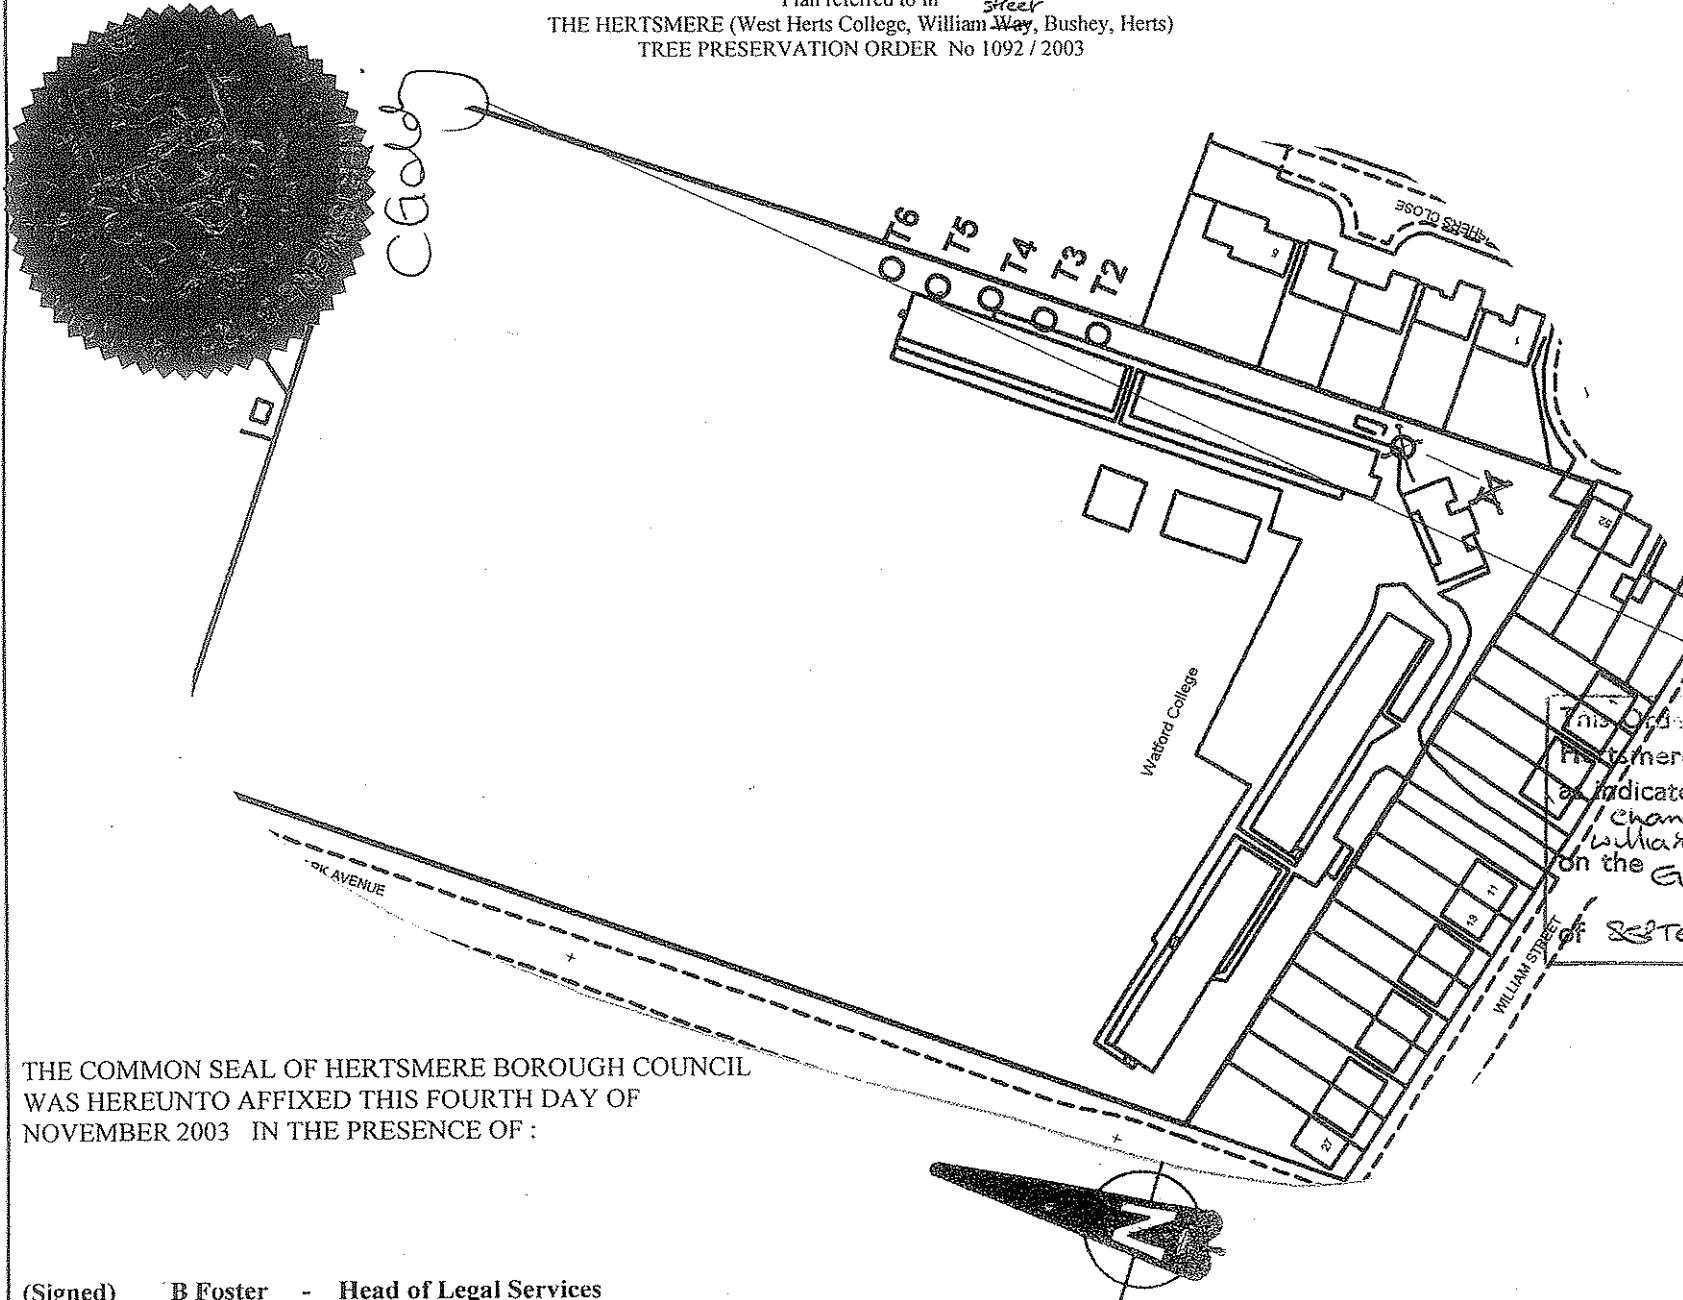

## SCHEDULE OF TREES

No	TYPE
<del>T1</del>	<del>BIRCH</del>
T2	BIRCH
T3	OAK
T4	BIRCH
T5	BIRCH
T6	OAK

This Order was VARIED by Hertsmere Borough Council as indicated on the Attached Plan. Change of address on plan from William Way to William Street on the EIGHTEENTH day of September in the year 2008

THE COMMON SEAL OF HERTSMERE BOROUGH COUNCIL  
 WAS HEREUNTO AFFIXED THIS FOURTH DAY OF  
 NOVEMBER 2003 IN THE PRESENCE OF :

(Signed) B Foster - Head of Legal Services

Map Ref. TQ 1199,9671

HERTSMERE  
 BOROUGH COUNCIL  
 Civic Offices  
 Borehamwood  
 Herts. WD6 1WA

SCALE 1:1250 DATE 4.11.2003

DRAWN *SM* CHECKED *CH*

DRAWING No TPO 1092/20034

Reproduced from the Ordnance Survey mapping with the permission of the Controller of Her Majesty's Stationery Office. © Crown Copyright reserved. Unauthorised reproduction infringes Crown copyright and may lead to prosecution or civil proceedings. Licence Number LA078239 Hertsmere, 2001.