


# TOWN AND COUNTRY PLANNING (TREES) REGULATIONS 1999

Plan referred to in THE HERTSMERE TREE PRESERVATION ORDER (Hillside School, Hillside Avenue, Borehamwood, Herts) No 36/2004

This Order was confirmed by the  
Hertsmere Borough Council subject to  
the modifications indicated by  
X ON THE PLAN  
on the THIRD day  
MAY in the year 2005

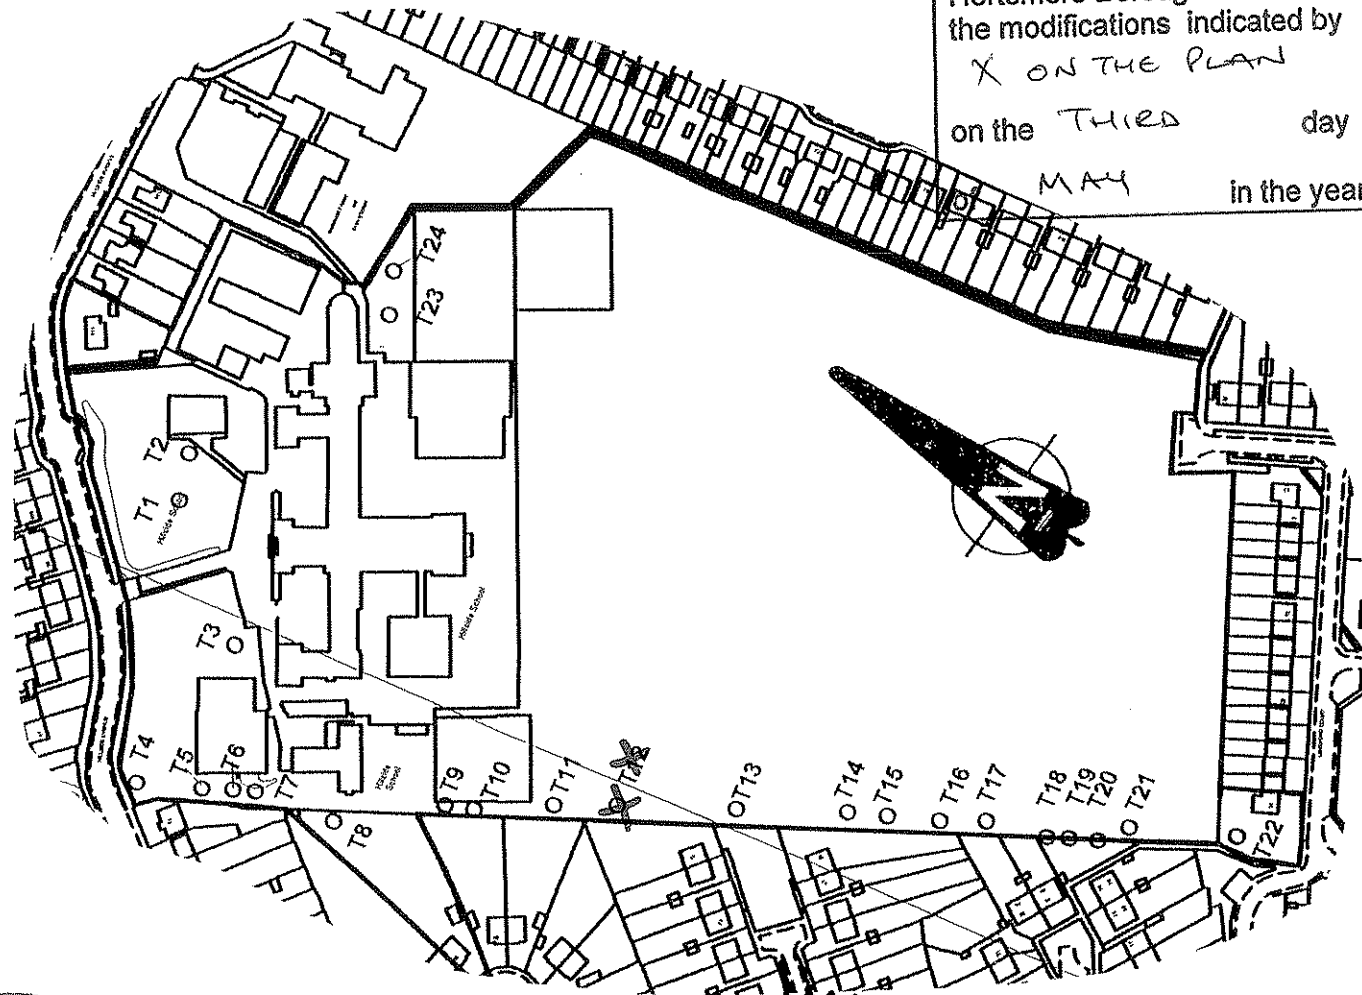

## SCHEDULE OF TREES

No	Type
T1	Oak
T2	Oak
T3	London Plane
T4	Oak
T5	Scots Pine
T6	Oak
T7	Oak
T8	Oak
T9	Oak
T10	Oak
T11	Oak
<del>T12</del>	<del>Oak</del>
T13	Oak
T14	Oak
T15	Oak
T16	Oak
T17	Beech
T18	Hawthorn
T19	Hawthorn
T20	Hornbeam
T21	Oak

Map Ref: TQ 2006,9648

Hertsmere Borough Council  
Civic Offices  
Borehamwood  
Herts WD6 1WA

SCALE: 1:2500 DATE: 07/12/2004

DRAWN BY: SW CHECKED

DRAWING NUMBER: 36/2004

THE COMMON SEAL OF HERTSMERE BOROUGH COUNCIL  
WAS HEREUNTO AFFIXED THIS Seventh day of December 2004

IN THE PRESENCE OF:

*Antonia Handley Legal Services*  
(Signed) Authorised Officer

with the permission of the Controller of Her Majesty's Stationery Office.  
Changes Crown copyright and may lead to prosecution or civil proceedings.  
Licence Number LA078239 Hertsmere, 2001.