


TOWN AND COUNTRY PLANNING (TREES) REGULATIONS 1999

Plan referred to in THE HERTSMERE TREE PRESERVATION ORDER (2,3,4,5,6,12 & 14 Mornington Road, Radlett, Herts) No 9/2005

This Order was confirmed by the Hertsmere Borough Council subject to the modifications indicated by a RED X AND RED LINE. ALSO A CHANGE OF TREE SPECIES on the first day of SEPTEMBER 2005 in the year

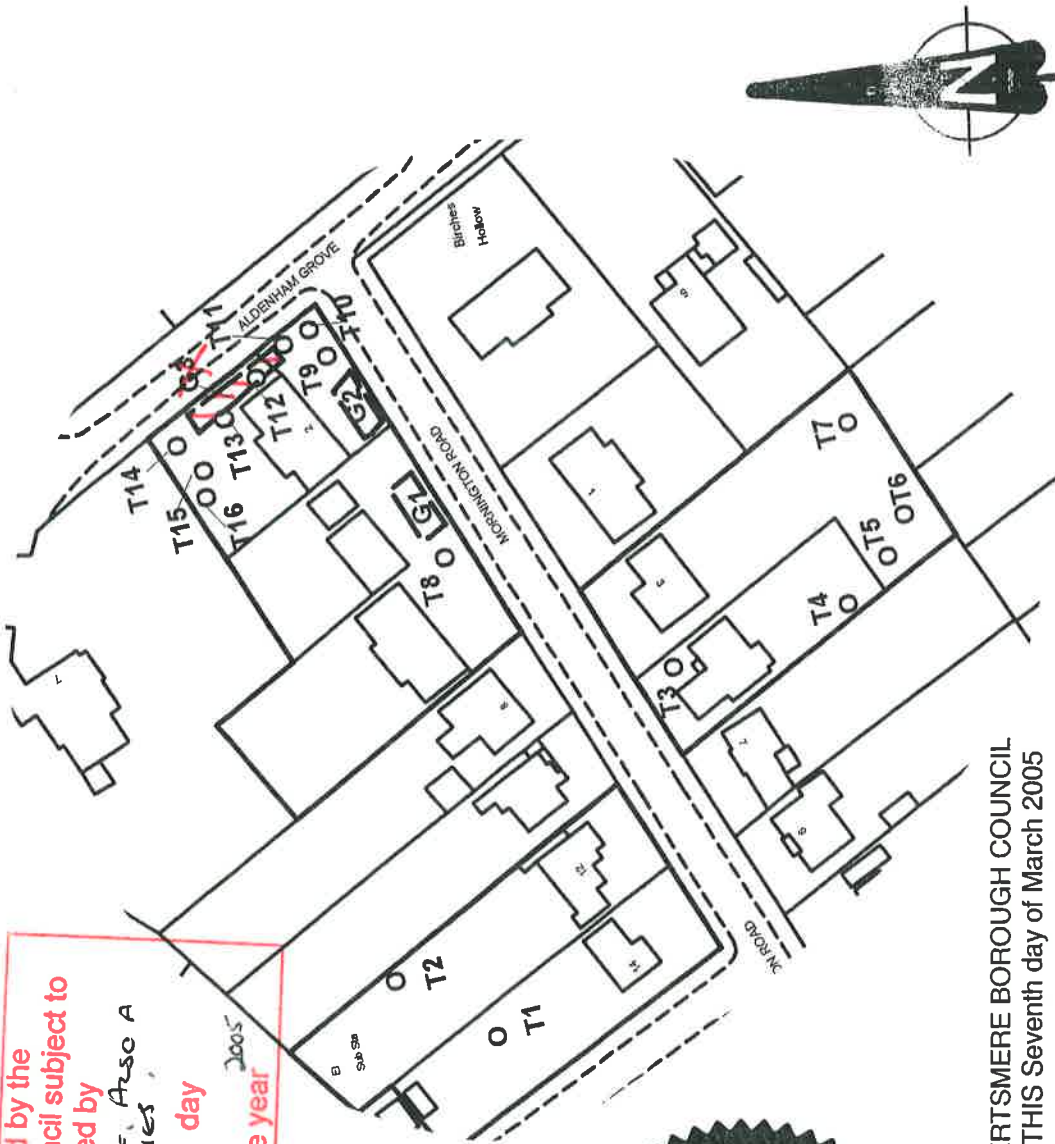

THE COMMON SEAL OF HERTSMERE BOROUGH COUNCIL WAS HEREONTO AFFIXED THIS Seventh day of March 2005

IN THE PRESENCE OF:

[Signature]
(Signed) Authorised Officer

Reproduced from the Ordnance Survey mapping with the permission of the Controller of Her Majesty's Stationary Office. © Crown Copyright reserved. Unauthorised reproduction infringes Crown copyright and may lead to prosecution or civil proceedings. Licence Number LA078239 Hertsmere, 2001.

SCHEDULE OF TREES

No	Type
T1	Oak
T2	Oak
T3	Yew
T4	Tulip Tree
T5	Cedar
T6	Larch
T7	Dawn Redwood
T8	Copper Beech
T9	Oak
T10	Hawthorn
T11	Oak
T12	Oak ASH 1.9.06
T13	Oak
T14	Oak (Twin Stemmed)
T15	Oak
T16	Oak
T17	SILVER BIRCH
G1	9.12 no. Cypress 1.9.05 Removed
G2	4 no. Cypress
G3	14 no. Cypress 1.9.05

Map Ref: TL 1652,0011

Hertsmere Borough Council
Civic Offices
Borehamwood
Herts WD6 1WA

SCALE: 1:1250 DATE: 07/03/2005

DRAWN BY: SW CHECKED *[Signature]*

DRAWING NUMBER: 9/2005