


TOWN AND COUNTRY PLANNING (TREES) REGULATIONS 1999

Plan referred to in THE HERTSMERE TREE PRESERVATION ORDER (Harperbury Hospital Site, Harper Lane, Radlett, Herts) No 33/2006

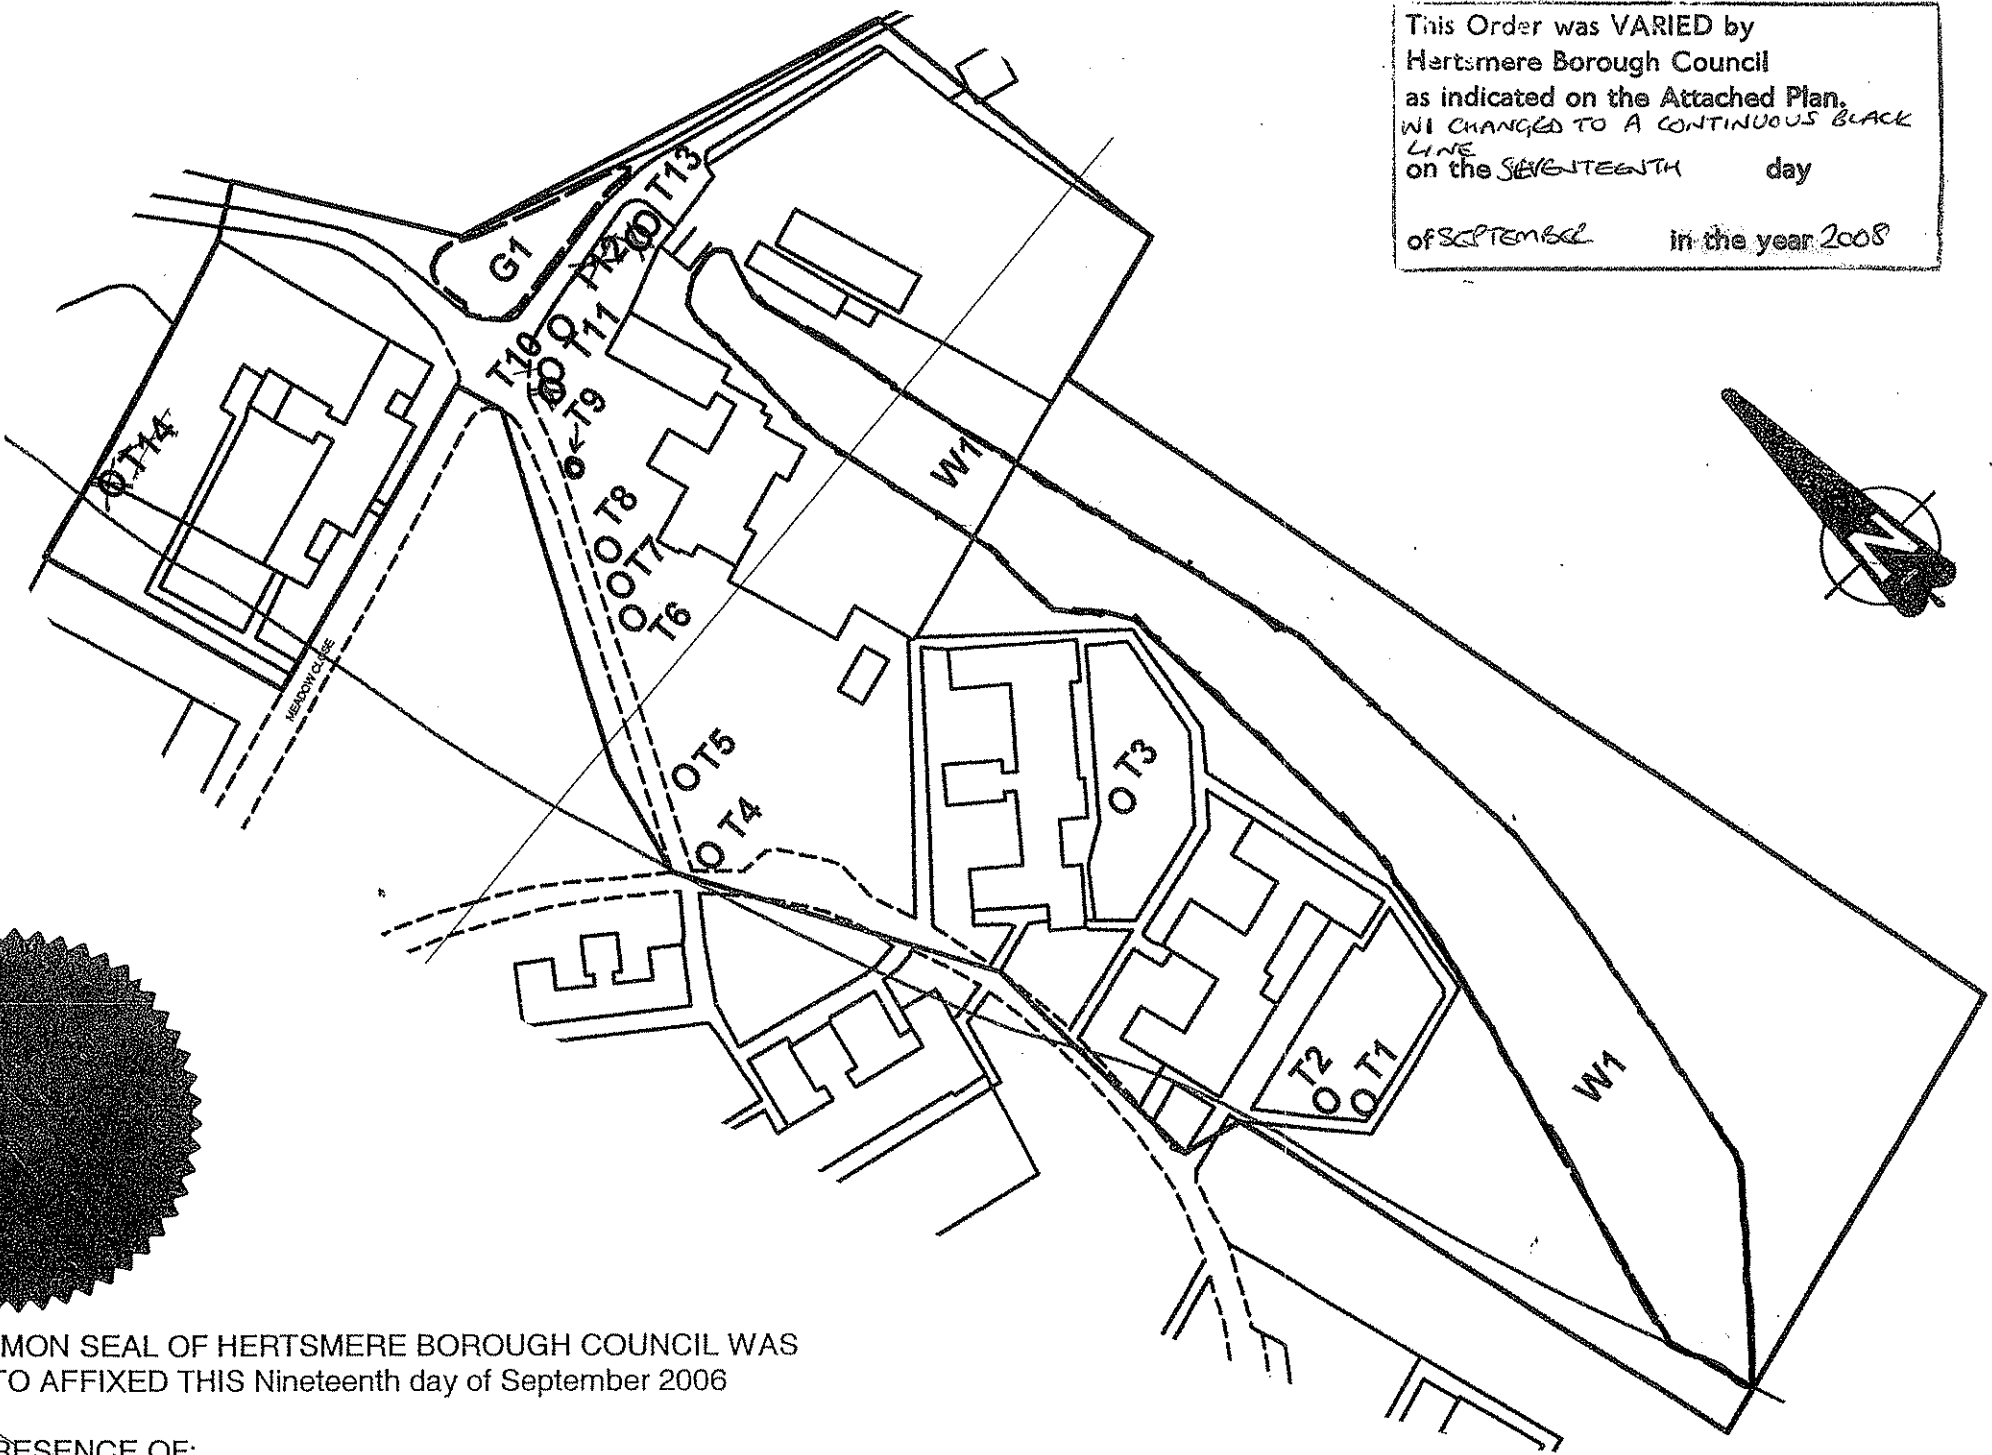

SCHEDULE OF TREES

No	Type
T1	Poplar
T2	Poplar
T3	Horse Chestnut
T4	Silver Maple
T5	Birch
T6	Silver Maple
T7	Birch
T8	Silver Maple
T9	Birch <i>REPOSITIONED 18.1.2007</i>
T10	Birch
T11	Silver Maple
<del>T12</del>	<del>Rowan REMOVED 18.1.2007</del>
T13	Poplar
<del>T14</del>	<del>Cherry REMOVED 18.1.2007</del>
G1	No.12 Limes
W1	Poplars, Willow, Lime, Pine, Leyland Cypress, Larch, Rowan, Holly, Ash, RedOak, Horse Chestnut, Beech, Cherry, Hawthorn, Yew and Laurel.

This Order was confirmed by the Hertsmere Borough Council subject to the modifications indicated by REMOVAL OF T12, T14 & REPOSITIONING OF T9 on the EIGHTEENTH day of JANUARY in the year 2007

Map Ref: TL 1752,0200

Hertsmere Borough Council  
Civic Offices  
Borehamwood  
Herts WD6 1WA

SCALE: 1:1250 DATE: 19/09/2006

DRAWN BY: SW CHECKED: *MS*

DRAWING NUMBER: 33/2006

THE COMMON SEAL OF HERTSMERE BOROUGH COUNCIL WAS  
HEREUNTO AFFIXED THIS Nineteenth day of September 2006

IN THE PRESENCE OF:

*[Signature]*

(Signed) Authorised Officer