


# TOWN AND COUNTRY PLANNING (TREES) REGULATIONS 1999

Plan referred to in THE HERTSMERE TREE PRESERVATION ORDER (23, 23a, 27 and 34 Shenley Hill, Radlett, Herts) No 27/2007

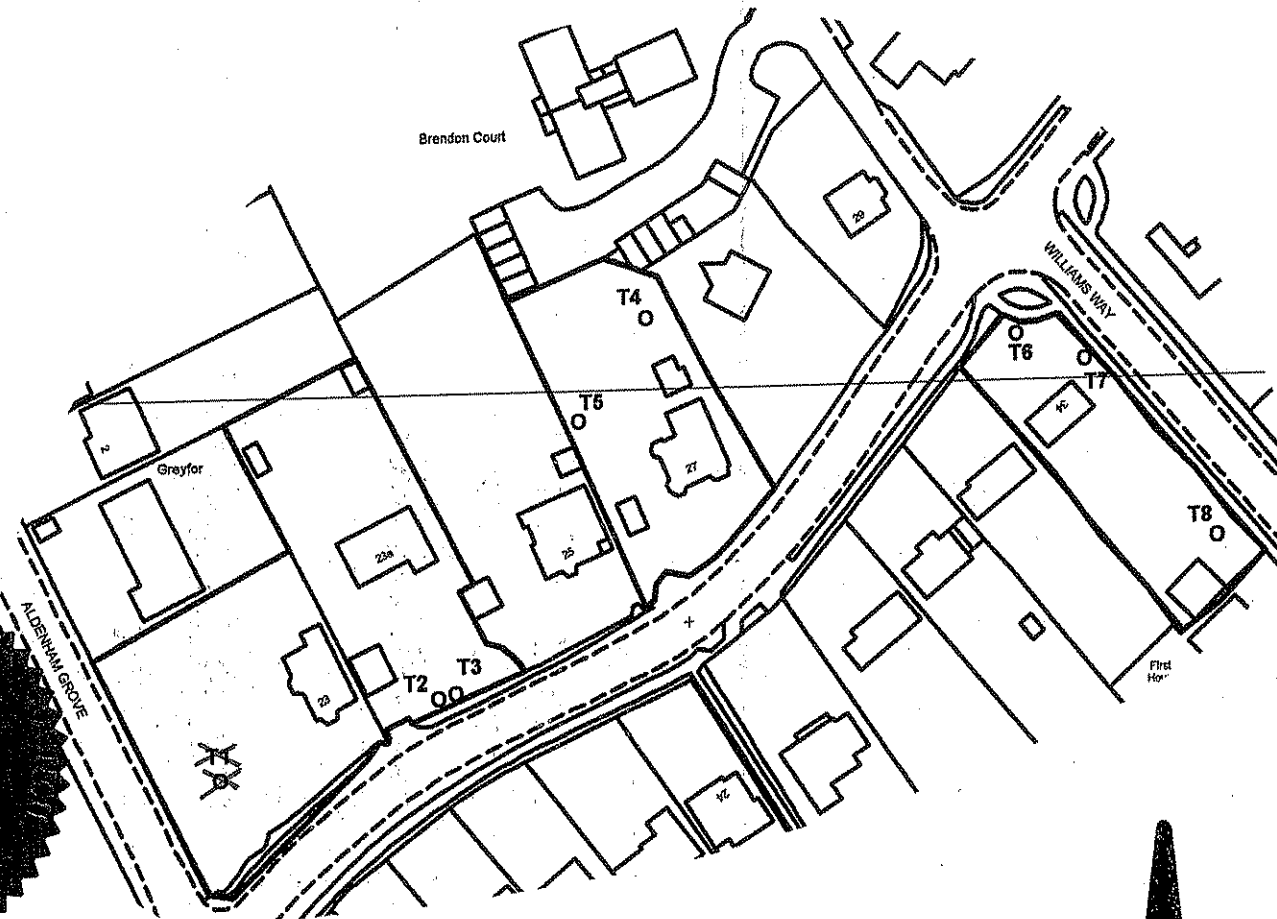

## SCHEDULE OF TREES

No	Type
<del>T1</del>	<del>Oak</del> <i>Removed 3.9.07</i>
T2	Oak
T3	Horse Chestnut
T4	Oak
T5	Robinia
T6	Sycamore
T7	Beech
T8	Oak

This Order was confirmed by the Hertsmere Borough Council subject to the modifications, indicated by *REMOVAL OF T1 OAK*

on the *THIRD* day  
of *SEPTEMBER* in the year *2007*

Map Ref: TQ 1669,9994

Hertsmere Borough Council  
Civic Offices  
Borehamwood  
Herts WD6 1WA

SCALE: 1:1250 DATE: 15/05/2007

DRAWN BY: SW CHECKED *MS*

DRAWING NUMBER: 27/2007

THE COMMON SEAL OF HERTSMERE BOROUGH COUNCIL  
WAS HEREUNTO AFFIXED THIS Fifteenth day of May 2007

IN THE PRESENCE OF:

(Signed) Authorised Officer

Reproduced from the Ordnance Survey mapping with the permission of the Controller of Her Majesty's Stationery Office.  
© Crown Copyright reserved. Unauthorised reproduction infringes Crown copyright and may lead to prosecution or civil proceedings.  
Licence Number LA078239 Hertsmere, 2001.