

PUBLIC PATH DIVERSION ORDER

HIGHWAYS ACT 1980, SECTION 119

HERTFORDSHIRE COUNTY COUNCIL

**HERTFORDSHIRE COUNTY COUNCIL (RIDGE 39 AND SHENLEY 39)
DIVERSION ORDER 2017**

This Order is made by Hertfordshire County Council ("the authority") under section 119 of the Highways Act 1980 ("the 1980 Act") because it appears to the authority that in the interests of the owner and the occupier of Crossoaks Farm and the public it is expedient that the line of the path should be diverted.

Hertfordshire County Council has agreed to defray any compensation which becomes payable in consequence of the coming into force of this order and any expenses which are incurred in bringing the new site of the path into a fit condition for use by the public.

Hertsmere Borough Council has been consulted as required by section 120(2) of the 1980 Act.

BY THIS ORDER

1. The public right of way over the land situate at Ridge and Shenley shown by a bold continuous line on the plan forming part of this Order ("the Order Plan") and described in Part 1 of the Schedule to this Order ("the Schedule") shall be stopped up on the date of confirmation of this Order.
2. There shall on the date of confirmation of this Order be a public bridleway over the land situate at Ridge and Shenley described in Part 2 of the Schedule and shown by a bold broken line on the Order Plan.
3. The rights conferred on the public under this Order shall be subject to the limitations and conditions set out in Part 3 of the Schedule.


SCHEDULE

PART 1

DESCRIPTION OF SITE OF EXISTING PATH OR WAY

The full width of that part of Bridleways Ridge 39 and Shenley 39 from a junction with Ridge BR 37 at TQ 2061 9987 (point A on the Order Plan) continuing generally north from Crossoaks Farm's yard for approximately 680 metres following the track along the Parish boundary and continuing through Bigpursley Wood to the junction with Shenley FP 20 and Ridge FP 23 at TL 2047 0053 (point B on the Order Plan) then continuing north and north

and Shenley Bridleway 17

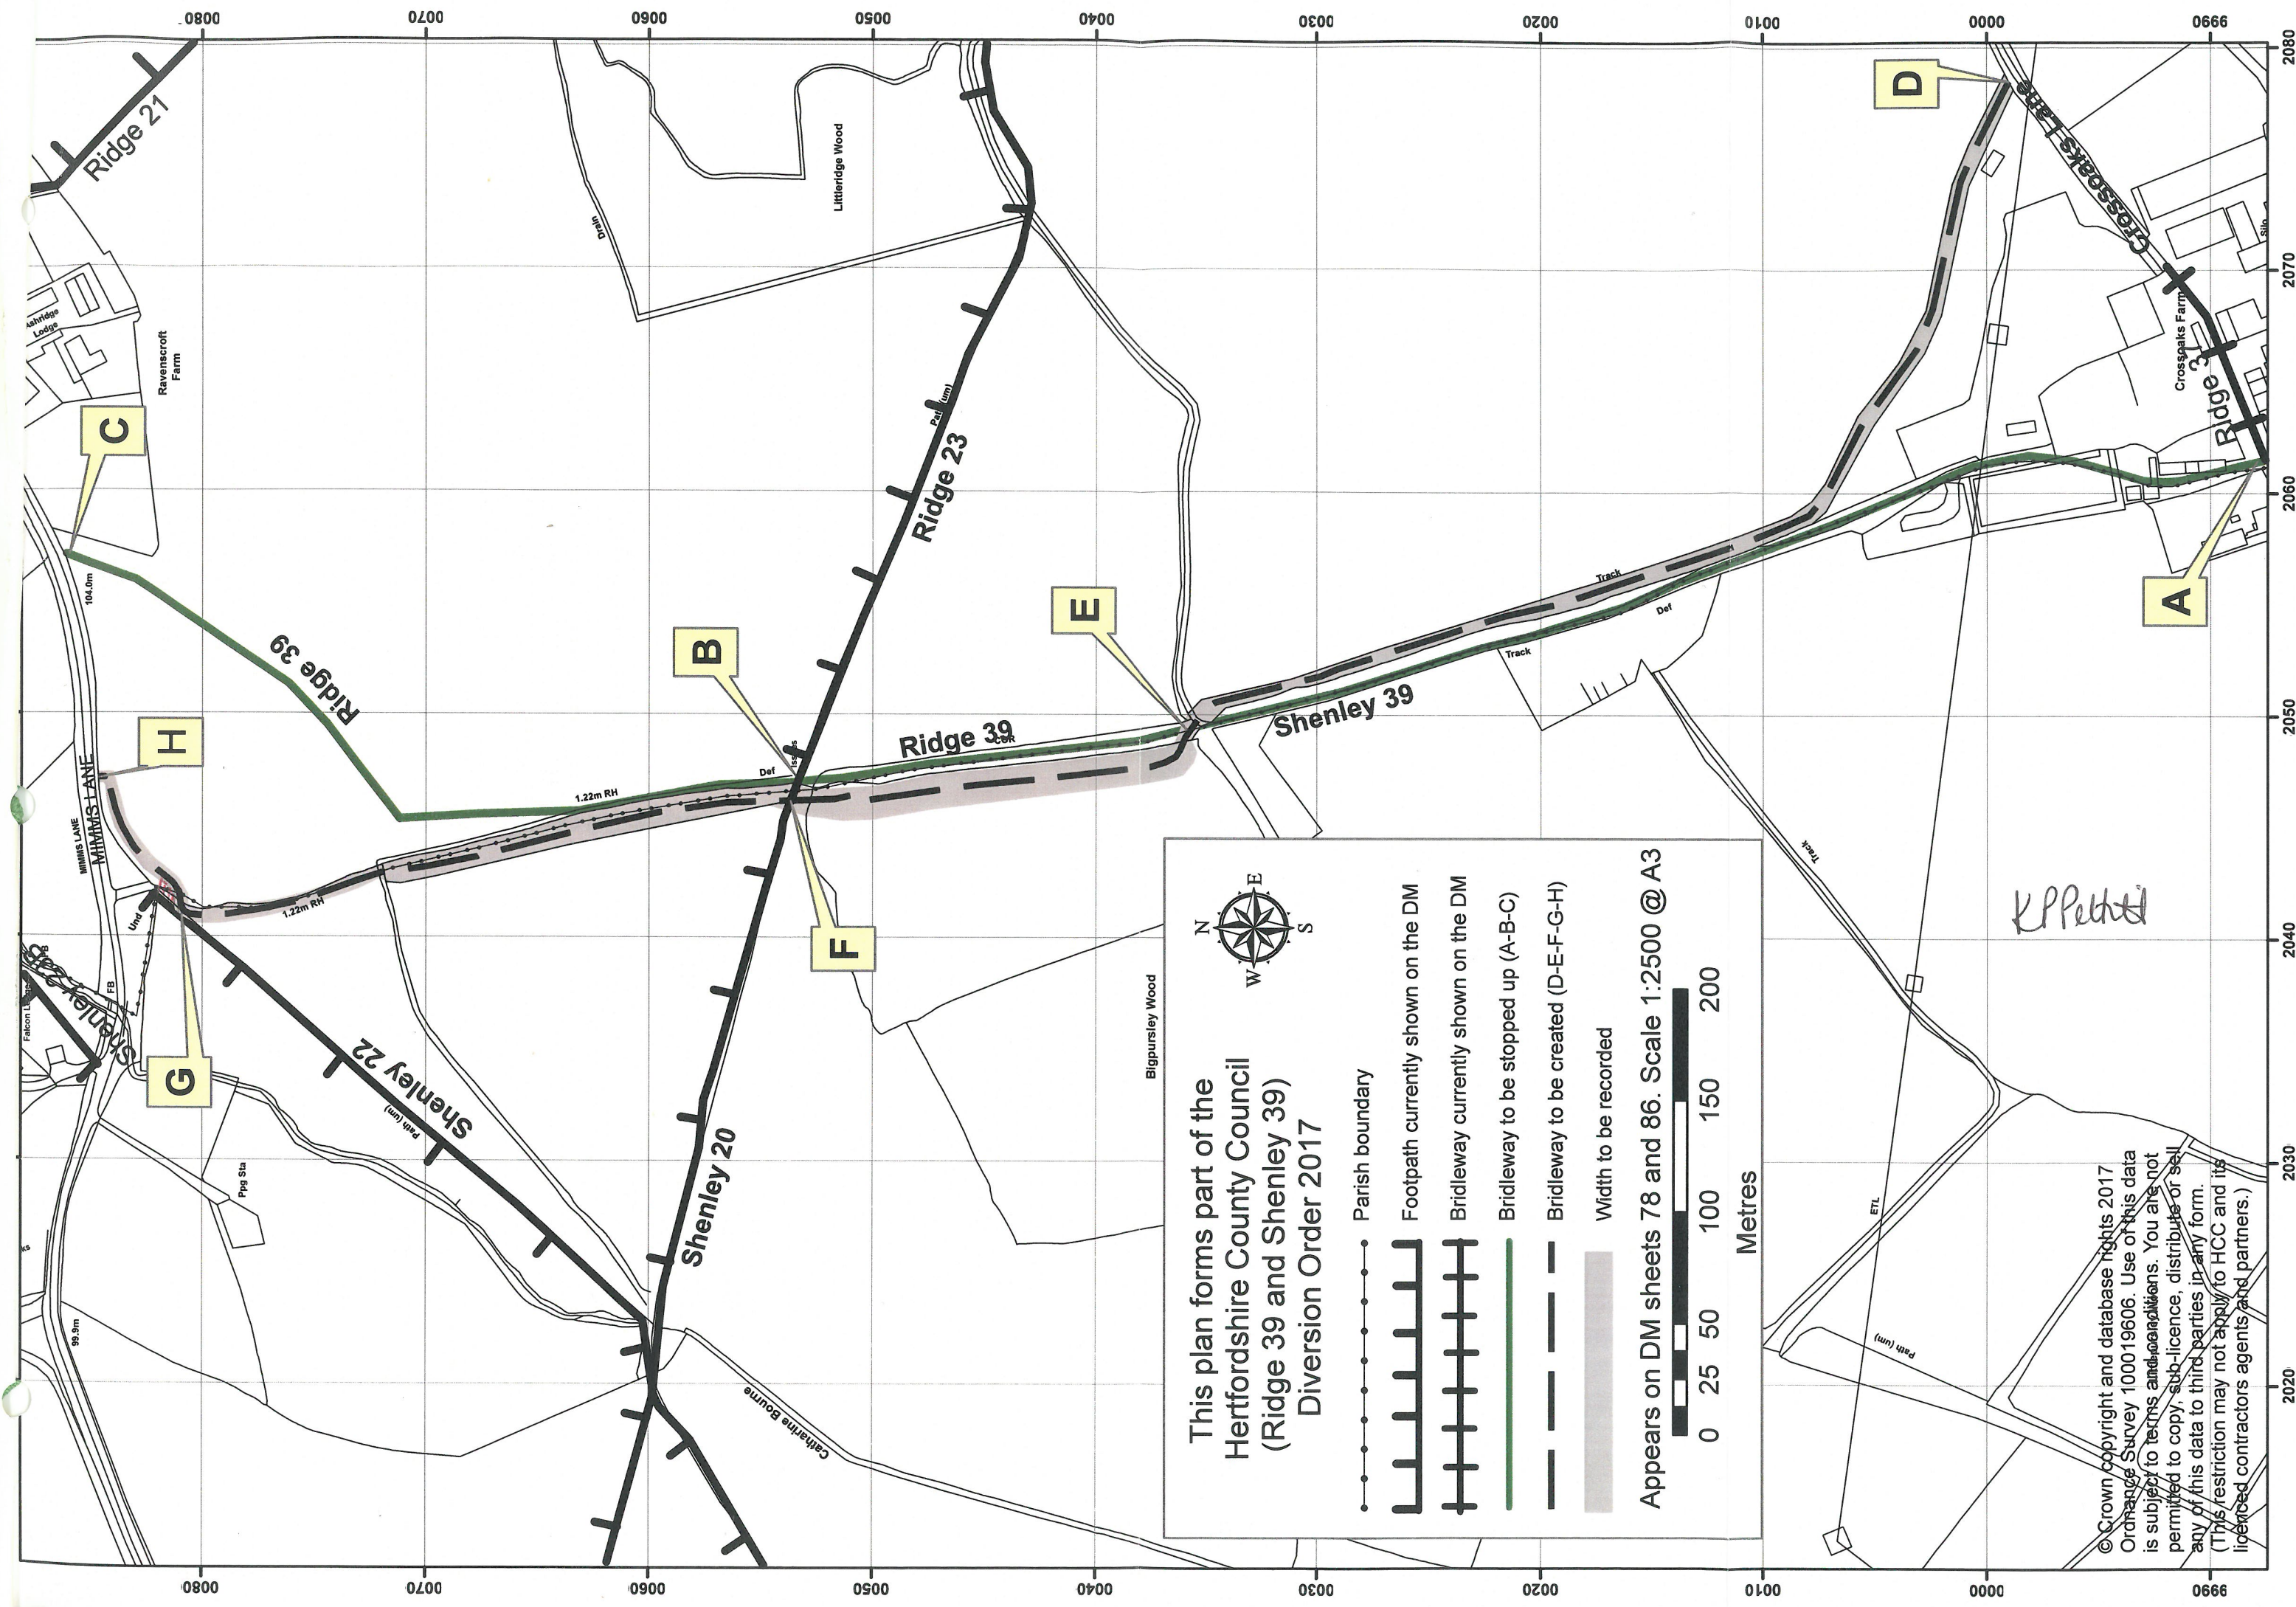

This plan forms part of the
Hertfordshire County Council
 (Ridge 39 and Shenley 39)
 Diversion Order 2017

Parish boundary
 Footpath currently shown on the DM
 Bridleway currently shown on the DM
 Bridleway to be stopped up (A-B-C)
 Bridleway to be created (D-E-F-G-H)
 Width to be recorded

Appears on DM sheets 78 and 86. Scale 1:2500 @ A3

0 25 50 100 150 200
 Metres

K.P.Petford

© Crown copyright and database rights 2017
 Ordnance Survey 100019606. Use of this data
 is subject to terms and conditions. You are not
 permitted to copy, sub-licence, distribute or sell
 any of this data to third parties in any form.
 (This restriction may not apply to HCC and its
 licenced contractors agents and partners.)

east for approximately 370 metres to join Mimms Lane at TL 2057 0086 (point C on the Order Plan).

PART 2

DESCRIPTION OF SITE OF NEW PATH OR WAY

A bridleway commencing from Crossoaks Lane (public road) at TQ 2078 9999 (point D on the Order Plan) running along the track in a generally west north west and north north west direction, north of Crossoaks Farm's yard for approximately 510 metres to the south east corner of Bigpursley Wood at TL 2049 0035 (point E on the Order Plan). Continuing generally north north west through Bigpursley Wood for approximately 185 metres to the junction with Shenley FP 20 and Ridge FP 23 at TL 2046 0053 (point F on the Order Plan). Continuing north north west for approximately 280 metres to a junction with Shenley FP 22 at TL 2041 0081 (point G on the Order Plan) then north east for approximately 75 metres to join Mimms Lane (public road) at TL 2047 0084 (point H on the Order Plan).

Width: Varying between 4 and 15 metres between TQ 2078 9999 (point D on the Order Plan) and TL 2047 0084 (point H on the Order Plan) as shown shaded grey on the Order plan.

(where the path connects to the north east with the southern corner of Registered Common Land CL295)

PART 3

LIMITATIONS AND CONDITIONS

None

IN WITNESS whereof the COMMON SEAL of HERTFORDSHIRE COUNTY COUNCIL was hereunto affixed this *8th* day of *September* 2017

The Common Seal of
HERTFORDSHIRE
COUNTY COUNCIL
was hereunto affixed
in the presence of:-

K P Pettitt
Kathryn Pettitt

Chief Legal Officer



The foregoing order is hereby confirmed
subject to the red ink modifications thereon.

Catherine Beeby 15 JUN 2023

An Inspector appointed by The Secretary of
State for Environment, Food and
Rural Affairs