TOWN AND COUNTRY PLANNING ACTS 1971-1974

Plan referred to in

THE HERTSMERE BOROUGH COUNCIL

(KEMPROW FARMHOUSE, KEMPROW ALDENHAM.)

TREE PRESERVATION ORDER No. 209 /1989

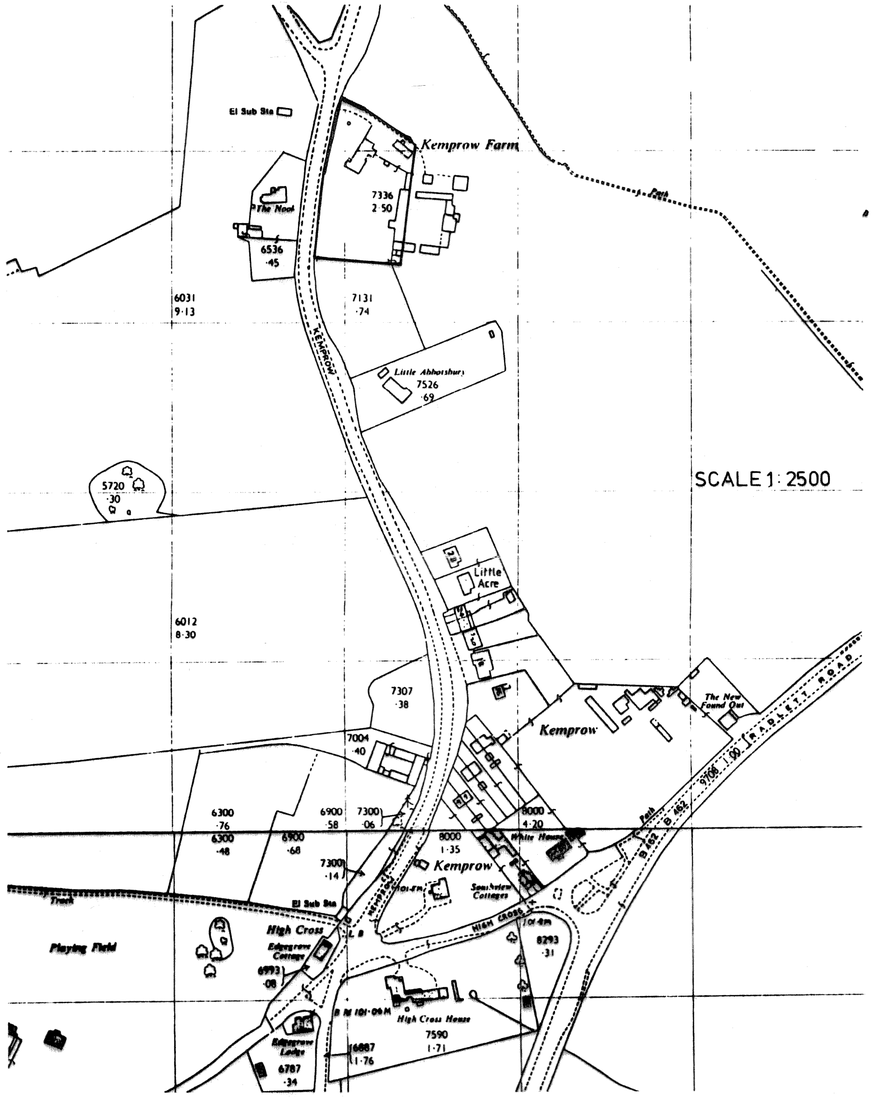

SCALE 1: 2500

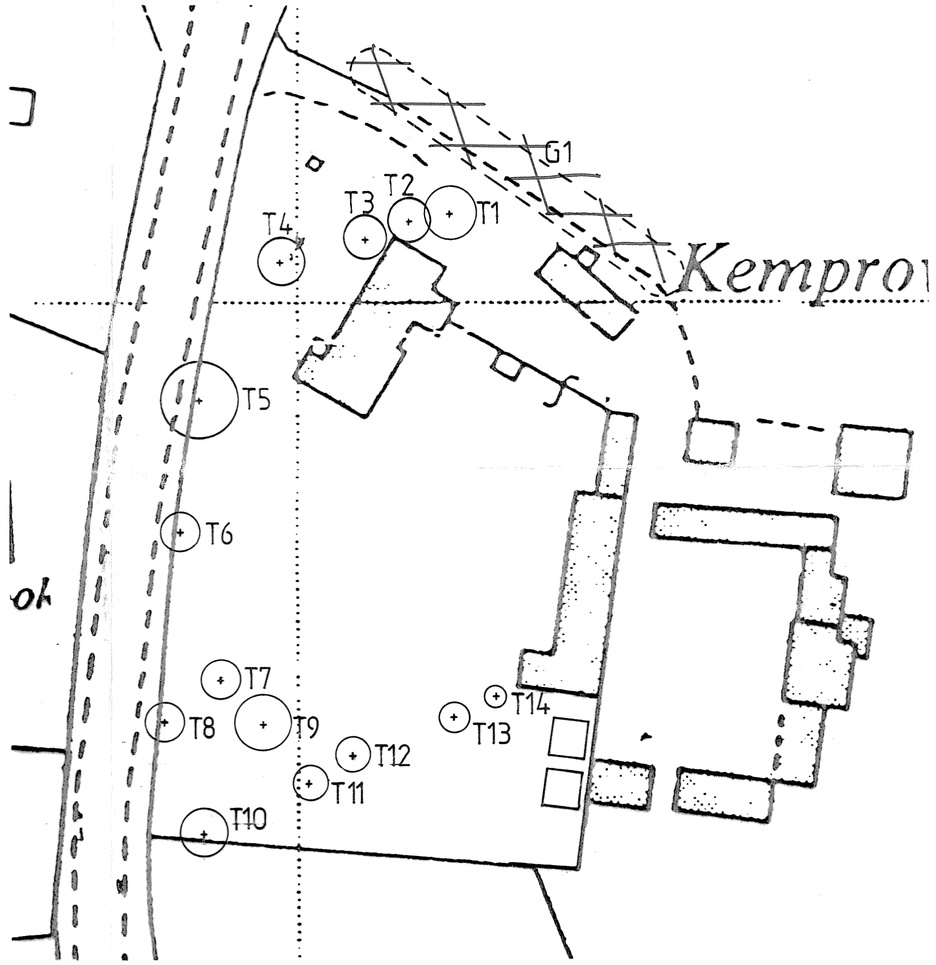

SCHEDULE OF TREES

No.	TYPE
~~G1~~	~~Box Hedge~~ Removed 14.12.2010
and	See T.P.O. 199/1989
T1-T5	T1 Cedar - T2 & T3 Thuja - T4 Cedar - T5 Horse Chestnut
T6	Field Maple
T7	Larch
T8	Birch
T9	Oak sp.
T10	C.Beech
T11	Ash
T12	Birch
T13	Wellingtonia
T14	Wellingtonia

THE COMMON SEAL OF HERTSMERE BOROUGH COUNCIL WAS HEREUNTO AFFIXED THIS TWENTY SIXTH DAY OF SEPTEMBER 1989 IN THE PRESENCE OF:

(Signed) M.J. JOHNSON ***MAYOR***

(Signed) R.T. LEWIS SOLICITOR

Reproduced from the Ordnance Survey map with the permission of the Controller of Her Majesty's Stationery Office. Crown Copyright reserved.

HERTSMERE
BOROUGH COUNCIL
Civic Offices
Elstree Way
Borehamwood
Herts WD6 1WA

SCALE 1:500	DATE 22/9/89
DRAWN S.D.M	CHECKED W.J.D
DRAWING No. TP 524	

AARQUE 2672/83